

USDA-FOREST SERVICE

Index File No. Z-6

T 5N R. 39E

Merid. WILL

CORNER RECORD (SEARCH)


(Ref. FSM 7151.4)

Tract or Survey No. _____ Cor. No. 4

R.D. WALLA WALLA County UNION/WALLOWA LINE

N.F. UMATILLA State OREGON

CORNER DIAGRAM

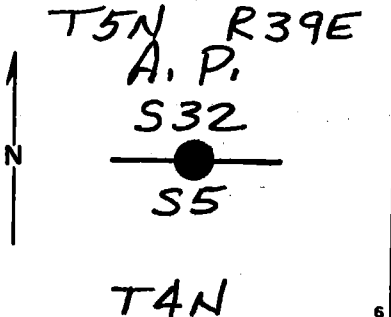

DESCRIBE CORNER MONUMENT FOUND

FOUND 1932 BRASS CAP IN GOOD CONDITION

DESCRIBE BEARING TREES OR OTHER OFFICIAL ACCESSORIES FOUND

ORIG. 7" PINE IS NOW A L.P.P. SNAG WITH FULL SCRIBES. BEARS N26°E, 11.2 ft.

ORIG. 7" PINE IS A LIVE L.P.P. WITH FULL SCRIBES VISIBLE. BEARS N72½ W, 7.9 ft.

DESCRIBE CORNER LOCATION RELATIVE TO NEAR-BY FEATURES, ALSO HOW TO REACH CORNER

NO TRACE OF ORIGINAL B.T.'S FOUND DOWN IN 1932.

CORNER IS 155 ft. WEST OF "K" TAG ON KENDALL SKYLINE ROAD.

PHOTO IDENTIFICATION DATA

Photo No. _____

Filed At. _____

Object Ident. _____

Ident. By _____

Signature

PLANE COORDINATE POSITION DATA

State _____ Zone _____

X _____

Y _____

Estab. By _____

Agency

Signature

Title

Division

Headquarters

Date

FS-7100-52 (3/68)

Dennis L. Haywood

PLS 1636

S.O.

6-12-85

CORNER RECORD (PERPETUATION)

MONUMENT: DESCRIBE NEW MONUMENT SET, OR WORK DONE TO PRESERVE EXISTING MONUMENT

9

ACCESSORIES : DESCRIBE NEW BT's WITNESS OBJECTS ETC. ESTABLISHED, OR WORK DONE TO PRESERVE EXISTING EVIDENCE

10

Work Done By _____ Title _____ Date _____ State Registration No.
or Agency _____

Certified Cor. Record Prepared ? Yes No Filed At: _____ Date _____ 11

REMARKS

12

Index File No. T. R. M. Tract or Surv. No. Cor. 13