


Index
 File No. 7-23
T. 4 S. R. 30 E.
 Merid. Willamette

CORNER RECORD (SEARCH)

(Ref. FSM 7151.4)

R.D. Ukiah County Umatilla Tract or Survey No. _____ Cor. No. _____
 N.F. Umatilla State Oregon

CORNER DIAGRAM

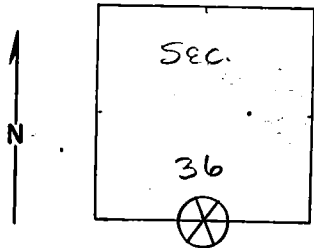

DESCRIBE CORNER MONUMENT FOUND

Material: Stone mound
 Markings: None visible

DESCRIBE BEARING TREES OR OTHER OFFICIAL ACCESSORIES FOUND

No BT's were established originally. None were available. There is a Pilot Rock Lumber Co. location poster on a 12" Ponderosa pine approximately 70' N 650 E., dated 11/56. 14"

PHOTO IDENTIFICATION DATA

Photo No. _____
 Filed At. _____
 Object Ident. _____
 Ident. By _____
Signature

PLANE COORDINATE POSITION DATA

State _____ Zone _____
 X _____
 Y _____
 Estab. By _____
Agency

DESCRIBE CORNER LOCATION RELATIVE TO NEAR-BY FEATURES, ALSO HOW TO REACH CORNER

Mound sets in open area near crest of hogback. It is the only mound in the vicinity; is very old and I assume it is the original. There is a primitive road about 600 feet north. (see Sugarbowl Creek 7.5 minute quad. map)

Signature
T. Hollamon

Title
Engr. Tech.

Division _____

Headquarters _____

Date
4/21/76

7100-52-(3/68)

CORNER RECORD (PERPETUATION)

MONUMENT: DESCRIBE NEW MONUMENT SET, OR WORK DONE TO PRESERVE EXISTING MONUMENT

9

ACCESSORIES : DESCRIBE NEW BT'S WITNESS OBJECTS ETC. ESTABLISHED, OR WORK DONE TO PRESERVE EXISTING EVIDENCE

I set an old native stake (which was lying nearby) in the center of the mound and tied orange ribbon on it.

10

Work Done By _____ Title _____ Date _____ State Registration No. or Agency _____

Certified Cor. Record Prepared ? Yes No Filed At _____ Date _____ 11

REMARKS

12

Index File No. T. R. M. Tract or Surv. No. Cor. 13