


CERTIFIED RECORD OF LAND CORNER MONUMENTATION

C-20

History of original corner establishment:

Unsurveyed - subdivided section

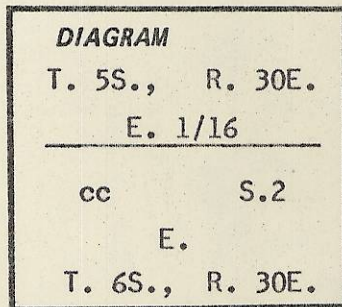

No record of subsequent remonumentation found in County Record.

Description of corner evidence found:


None.

Description of monument and accessories established to perpetuate the original location of this corner:

Set 2 1/2" x 30" iron pipe 15" in ground with a brass cap marked as shown. From which I scribed Bearing Trees:

- A 10" fir bears S. 33°47' E. 54.9 ft. mkd. E. 1/16 CC S.2 BT.
- A 10" fir bears S. 39°17' W. 25.6 ft. mkd. E. 1/16 CC S.2 BT.

Nailed a brass washer mkd. P.L.S. 933 on the BT blaze on both trees. Set a steel fence post 3.5 ft. East of corner. The corner is 14 ft. South of a E-W fence line. Raised mound of stone 3 ft. base within 3" of top of pipe. Used transit and steel tape, measuring to center of BTs.

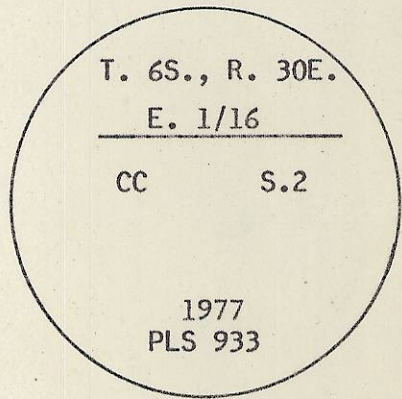

REGISTERED PROFESSIONAL LAND SURVEYOR

David H. Krumbain  
OREGON  
JULY 17, 1970  
DAVID H. KRUMBEIN  
933

Office of.....County Surveyor..... County of.....Umatilla.....  
State of.....Oregon....., I hereby certify that the within instrument was filed in this office  
for record on the..... day of....., 19.....  
David H. Krumbain by.....  
(COUNTY OFFICIAL) (DEPUTY)

C-20

S-160-R

S-160