

USDA-FOREST SERVICE

Index
File No. G-21
T 58 R. 30E
Merid. W.M.


CORNER RECORD (SEARCH)

(Ref. FSM 7151.4)

R.D. N. Fk. J. D. County Umatilla
N.F. Umatilla State Or.

Tract or
Survey No. _____
Cor.
No. _____

CORNER DIAGRAM

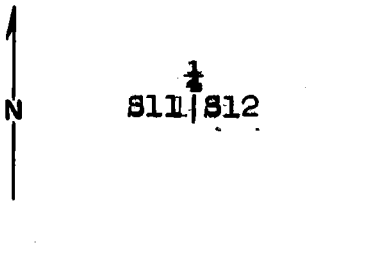

DESCRIBE CORNER MONUMENT FOUND

2 1/2" iron pipe, brass cap mkd.:

T58 R30E

S11 S12

1974

PLS 644

DESCRIBE BEARING TREES OR OTHER OFFICIAL ACCESSORIES FOUND

P. Pine, 15", S79 1/2 W, 146.5'; healed blaze.
P. Pine, 16", dead and down, stump bears S18E, 81.1'

PHOTO IDENTIFICATION DATA

Photo No. _____
Filed At. _____
Object Ident. _____
Ident. By _____
Signature

DESCRIBE CORNER LOCATION RELATIVE TO NEAR-BY FEATURES, ALSO HOW TO REACH CORNER

Cor. falls in open on slight Sly slope, N of 030 rd.

PLANE COORDINATE POSITION DATA

State _____ Zone _____
X _____
Y _____
Estab. By _____
Agency

Signature

FL Munro

Title

PLS

Division

Headquarters

Date

10/26/89

FS-7100-52 (3/68)

CORNER RECORD (PERPETUATION)

MONUMENT: DESCRIBE NEW MONUMENT SET, OR WORK DONE TO PRESERVE EXISTING MONUMENT

9

ACCESSORIES : DESCRIBE NEW BT'S WITNESS OBJECTS ETC. ESTABLISHED, OR WORK DONE TO PRESERVE EXISTING EVIDENCE

New BT: P. Pine, 11", N50E, 56.1'; mhd.: $\frac{1}{2}$ S12 BT
 BTs have red blaze, band, BT tags and 54-9 signs. New BT has alum.
 "PLS 1832" washer. 6' fence post with 54-9 sign within 5' of cor.

10

Work Done By F.S. Munro Title PLS Date 5/24/89 State Registration No. 1832
 or Agency

Certified Cor. Record Prepared ? Yes No Filed At: Umatilla Co. Surveyor Date

11

REMARKS

12

Index File No. G-21 T. 58 R. 30E M. W.M. Tract or Surv. No. Cor.

13

Index
File No. G-21


CORNER RECORD (SEARCH)
(Ref. FSM 7151.4)

Tract or
Survey No. _____
Cor.
No. _____

T 5 S R. 30 E
Merid. Willamette

R.D. Ukiah County Umatilla
N.F. Umatilla State Oregon

CORNER DIAGRAM

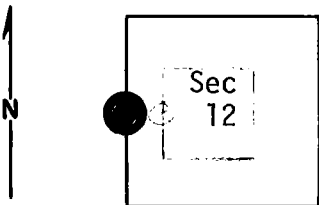

DESCRIBE CORNER MONUMENT FOUND

BRASS CAP - 74

● *see mon. file*

2

DESCRIBE BEARING TREES OR OTHER OFFICIAL ACCESSORIES FOUND

12" PP w/blaze 18" above ground on NE face; scribe mark visible but not readable. B.T. poster on tree dated 5-72 WLE
Paced 222 links N 78° E from BT and found mound of stone along abandoned fence line.
6" PP 5' East of mound with faded FS location poster on west side.

3

DESCRIBE CORNER LOCATION RELATIVE TO NEAR-BY FEATURES, ALSO HOW TO REACH CORNER

1 Paced N 160' to old log road and put up location poster 54-5.

4

PHOTO IDENTIFICATION DATA

Photo No. _____
Filed At. _____
Object Ident. _____
Ident. By _____
Signature

6

7

PLANE COORDINATE POSITION DATA

State _____ Zone _____
X _____
Y _____
Estab. By _____
Agency

8

Signature
B. Moore

Title
Eng. Tech.

Division
Umatilla

Headquarters
S. O.

Date
8/73

7100-52-(3/68)

5

CORNER RECORD (PERPETUATION)

MONUMENT: DESCRIBE NEW MONUMENT SET, OR WORK DONE TO PRESERVE EXISTING MONUMENT

ACCESSORIES : DESCRIBE NEW BT'S WITNESS OBJECTS ETC. ESTABLISHED, OR WORK DONE TO PRESERVE EXISTING EVIDENCE

Work Done By _____ Title _____ Date _____ State Registration No. _____
or Agency _____

Certified Cor. Record Prepared? Yes No Filed At: _____ Date _____

REMARKS

Index File No. *G-21* T. R. M. Tract or Surv. No. Cor.