

Index
File No. G-8

CORNER RECORD (SEARCH)
(Ref. FSM 7151.4)

Tract or
Survey No. _____ Cor.
No. _____


T 55 R. 30E

R.D. Ukiah County Umatilla

Merid. Willamette

N.F. Umatilla State Ore.

CORNER DIAGRAM

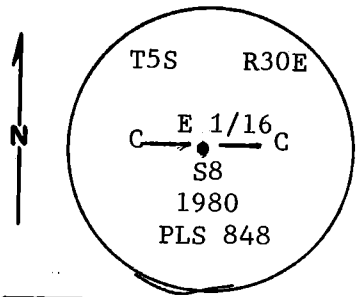

DESCRIBE CORNER MONUMENT FOUND

Corner not previously established.

DESCRIBE BEARING TREES OR OTHER OFFICIAL ACCESSORIES FOUND

N.A.

PHOTO IDENTIFICATION DATA

Photo No. _____
Filed At. _____
Object Ident. _____
Ident. By _____
Signature

DESCRIBE CORNER LOCATION RELATIVE TO NEAR-BY FEATURES, ALSO HOW TO REACH CORNER

Corner is on an old abandoned road. Go east 1/4 mi. from Gilman ranch cabin.

PLANE COORDINATE POSITION DATA

State _____ Zone _____
X _____
Y _____
Estab. By _____
Agency

Signature _____ Title _____ Division _____ Headquarters _____ Date _____

CORNER RECORD (PERPETUATION)

MONUMENT: DESCRIBE NEW MONUMENT SET, OR WORK DONE TO PRESERVE EXISTING MONUMENT

Set 3"x30" galv iron pipe with 3" brass cap, 20" in the ground & raised a mound of stone around pipe. Stamped brass cap as shown in the diagram.

ACCESSORIES : DESCRIBE NEW BT'S WITNESS OBJECTS ETC. ESTABLISHED, OR WORK DONE TO PRESERVE EXISTING EVIDENCE

From which:

A pine 14" dia. bears N 13 W 74.7 ft. scribed C E 1/16 S8 BT.

A pine 9" dia. bears S 30 30'W 33.5 ft. " " " " "

Nailed brass washers stamped PLS 848 & bearing tree signs to each tree, painted red band around each tree.

Set steel posts with warning & bdry signs 8' S & 7' W

Bearing solar grid

Work Done By D. M. Ferguson Title Surveyor Date 9-3-80 State Registration No. PLS 848
or Agency

Certified Cor. Record Prepared Yes No Filed At: _____ Date _____

REGISTERED
**PROFESSIONAL
LAND SURVEYOR**

REMARKS

Witness to above corner.
L. Wyllie

D. M. Ferguson
OREGON
JULY 12, 1968
DOUGLAS M. FERGUSON
848

Index File No. _____ T. _____ R. _____ M. _____ Tract or Surv. No. _____ Cor. _____
U.S. G.P.O. 1977-725-576/586