


Index File No. N-13
 T 5 S R. 30 E
 Merid. Willamette

CORNER RECORD (SEARCH)
 (Ref. FSM 7151.4)

Tract or Survey No. _____
 Cor. No. _____

R.D. Ukiah County Umatilla
 N.F. Umatilla State Oregon

CORNER DIAGRAM

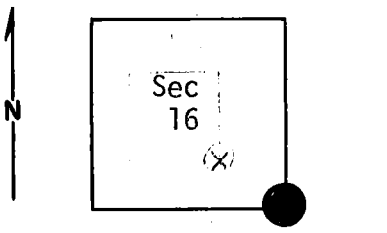

DESCRIBE CORNER MONUMENT FOUND

Basalt stone, generally fits GLO description, 6" above ground, good condition, markins not legible.

Brass Cap! see Monumentation File.

2

DESCRIBE BEARING TREES OR OTHER OFFICIAL ACCESSORIES FOUND

Large stone surrounded by general circle of smaller stones. Stake with hub tack. 36" PP bears S.10°W, approx. 75 links. Closed blaze, no scribing visible. 36" PP bears S. 20°E, approx. 98 lks. Blaze nearly closed, some scribing visible but illegible. FS poster 54-4. 36" PP bears N.42°E, approx. 134 lks. Blaze recently opened and somewhat pitched over. Some visible but illegible
 (cont on back)

PHOTO IDENTIFICATION DATA

Photo No. _____
 Filed At. _____
 Object Ident. _____
 Ident. By _____
Signature

6

DESCRIBE CORNER LOCATION RELATIVE TO NEAR-BY FEATURES, ALSO HOW TO REACH CORNER

From New Western Route Road, proceed southerly on Road S-420 for about 3 miles to a point about 500' N. of Sec. line between Secs. 16 and 21. Thence southeasterly on an old jeep road for about 800'. A B.T. is visible about 50' west.

PLANE COORDINATE POSITION DATA

State _____ Zone _____
 X _____
 Y _____
 Estab. By _____
Agency

8

Signature	Title	Division	Headquarters	Date	7100-52-(3/68)
T Hollamon	Eng Tech	Umatilla	S.O.	9/19/73	

4

5

CORNER RECORD (PERPETUATION)

MONUMENT: DESCRIBE NEW MONUMENT SET, OR WORK DONE TO PRESERVE EXISTING MONUMENT

9

ACCESSORIES : DESCRIBE NEW BT'S WITNESS OBJECTS ETC. ESTABLISHED, OR WORK DONE TO PRESERVE EXISTING EVIDENCE

10

Work Done By _____ Title _____ Date _____ State Registration No. or Agency _____

Certified Cor. Record Prepared ? Yes No Filed At: _____ Date _____

11

Accessories

REMARKS

~~Location~~ cont.: scribing 6" to 8" deep. F.S. poster 54-4. 40" partially rotted PP stump bears N. 90° W., approx. 225 links. A long butt (from this stump) lies approx. 20' NW. If this long butt is scribed, it should be on the side touching the ground.

A location poster on 8" Pi Pine 10' South of Corner Stone, Also Location poster on section line 50 feet West of Road S-420. Corner satisfactory for monumentation.

12

Index File No. *N-13* T. R. M. Tract or Surv. No. Cor. 13