

USDA-FOREST SERVICE

4

CORNER RECORD (SEARCH)

(Ref. FSM 7151.4)

Index File No. F1/2-7

Tract or Survey No. _____ Cor. No. _____


T 55 R. 30E

R.D. Ukiah County Umatilla

Merid. Willamette

N.F. Umatilla State Ore.

CORNER DIAGRAM

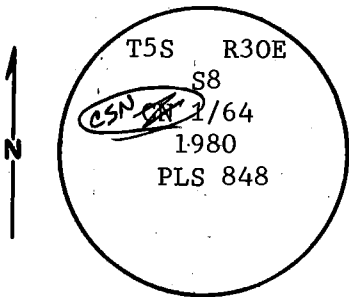

DESCRIBE CORNER MONUMENT FOUND

Corner not previously set.

DESCRIBE BEARING TREES OR OTHER OFFICIAL ACCESSORIES FOUND

N.A.

PHOTO IDENTIFICATION DATA

Photo No. _____

Filed At. _____

Object Ident. _____

Ident. By _____

Signature

PLANE COORDINATE POSITION DATA

State _____ Zone _____

X _____

Y _____

Estab. By _____

Agency

Signature

Title

Division

Headquarters

Date

7100-52-(3/68)

6

7

8

2

3

4

5

CORNER RECORD (PERPETUATION)

MONUMENT: DESCRIBE NEW MONUMENT SET, OR WORK DONE TO PRESERVE EXISTING MONUMENT*

Set 3"x30" galv iron pipe with 3" brass cap 18" in the ground & raised a mound of stone around pipe. Stamped brass cap as shown in diagram.

ACCESSORIES : DESCRIBE NEW BT'S WITNESS OBJECTS ETC. ESTABLISHED, OR WORK DONE TO PRESERVE EXISTING EVIDENCE

From which:

A pine 7" dia. bears N63 30 W 22.6ft. scribed ^{CSN} ~~(X)~~ 1/64 S8 BT

A pine 18" dia. bears N 38 E 64.4ft. " ~~(X)~~ " " "

Nailed brass washers stamped PLS 848 & bearing tree signs to each tree; painted red band around each tree.

Set steel posts with bdy. & warning signs 8'N & 8'E from corner.

Bearing- Solar Grid.

Work Done By D.M. Ferguson Title Surveyor Date 9-8-80 State Registration No. or Agency PLS 848

Certified to be Properly Prepared? Yes No Filed At: _____ Date _____

**PROFESSIONAL
LAND SURVEYOR**

REMARKS

Witnesses to above corner.
D. Herburger
L. Wyllie

**OREGON
JULY 12, 1968
DOUGLAS M. FERGUSON
848**

Index File No. T. R. M. Tract or Surv. No. Cor. U.S. G.P.O. 1977-725-576/586