

USDA-FOREST SERVICE

6

CORNER RECORD (SEARCH)

(Ref. FSM 7151.4)


Index File No. G-5 1/2

Tract or Survey No. _____ Cor. No. _____

T 55 R. 30E R.D. Ukiah County Umatilla

Merid. Willamette N.F. Umatilla State Ore.

CORNER DIAGRAM

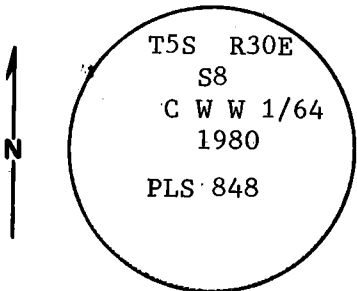

DESCRIBE CORNER MONUMENT FOUND

Corner not previously established.

DESCRIBE BEARING TREES OR OTHER OFFICIAL ACCESSORIES FOUND

N.A.

PHOTO IDENTIFICATION DATA

Photo No. _____

Filed At. _____

Object Ident. _____

Ident. By _____

Signature

PLANE COORDINATE POSITION DATA

State _____ Zone _____

X _____

Y _____

Estab. By _____

Agency

DESCRIBE CORNER LOCATION RELATIVE TO NEAR-BY FEATURES, ALSO HOW TO REACH CORNER

Corner is on the west edge of a lodge pole thicket & can be found by following the marked forest bdry. from the 5312 road north & west from a point approx. 1/4 mile S-W from the Gilman ranch cabin.

Signature

Title

Division

Headquarters

Date

7100-52-(3/68)

CORNER RECORD (PERPETUATION)

MONUMENT: DESCRIBE NEW MONUMENT SET, OR WORK DONE TO PRESERVE EXISTING MONUMENT.

Set 3"x30" galv iron pipe with 3" brass cap 20" in the ground. Stamped brass cap as shown in the diagram.

ACCESSORIES : DESCRIBE NEW BT's WITNESS OBJECTS ETC. ESTABLISHED, OR WORK DONE TO PRESERVE EXISTING EVIDENCE

From Which:

A fir 17" dia. bears N 4 E 11.2 ft. scribed C W W 1/64 S8 BT.

A fir 10" dia. bears S 3 W 16.3 ft. " C W W 1/64 S8 BT.

Nailed brass washers stamped PLS 848 & bearing tree signs to each tree, painted red band around each tree.

Set steel posts with warning & bdry. signs 5' N & 5' E

Bearing mag. compas 20 E Dec.

Work Done By. D. M. Ferguson Title Surveyor Date 9-8-80 State Registration No. or Agency PLS 848

Certified Cor. Record Prepared? Yes No Filed At: _____ Date _____

REGISTERED
PROFESSIONAL
LAND SURVEYOR

REMARKS

Witness to above corner.

L. Wyllie

OREGON
JULY 12, 1968
DOUGLAS M. FERGUSON
848

Index File No. J. R. M. Tract or Surv. No. Cor. U.S. G.P.O. 1977-725-576/586