

USDA-FOREST SERVICE

Index

File No. R-17

T 6S R. 30E

Merid. Willamette

2
CORNER RECORD (SEARCH)


(Ref. FSM 7151.4)

Tract or Survey No. _____ Cor. No. R-17

R.D. Ukaih County _____

N.F. Umatilla State Oregon

CORNER DIAGRAM

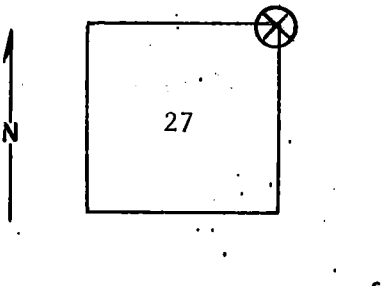

DESCRIBE CORNER MONUMENT FOUND

None

DESCRIBE BEARING TREES OR OTHER OFFICIAL ACCESSORIES FOUND 2

A 32" Pond. Pine, high stump, with visable scribing on S.E. face. A 21" ~~Old, Oube wutz~~ visible scribing on East Face. Both B.T.s have Georgia Pacific. location posters.

Pond. Pine with

PHOTO IDENTIFICATION DATA 6

Photo No. _____

Filed At. _____

Object Ident. _____

Ident. By _____

Signature

PLANE COORDINATE POSITION DATA 7

State _____ Zone _____

X _____

Y _____

Estab. By _____

Agency

DESCRIBE CORNER LOCATION RELATIVE TO NEAR-BY FEATURES, ALSO HOW TO REACH CORNER 3

Record: stone 18 x 15 x 6

30" Pine N48W 33 Rks

8" Pine S79W 93 Rks

Signature

T. HOLLAMON

Title

ENG. TECH.

Division

Headquarters

Date

8/17/78

7100-52-(3/68)

5

CORNER RECORD (PERPETUATION)

 MONUMENT: DESCRIBE NEW MONUMENT SET, OR WORK DONE TO PRESERVE EXISTING MONUMENT

9

 ACCESSORIES: DESCRIBE NEW BT'S WITNESS OBJECTS ETC. ESTABLISHED, OR WORK DONE TO PRESERVE EXISTING EVIDENCE

Placed blank B.T. tags and attention posters on both B.T.s. Also placed a location poster on a 14" Doug fir approx. 300 ft. North of corner beside old road.

10

 Work Done By _____ Title _____ Date _____ State Registration No. or Agency _____

 Certified Cor. Record Prepared? Yes No Filed At: _____ Date _____

REMARKS

12

Index File No.

T.

R.

M.

Tract or Surv. No.

Cor.

13