

USDA-FOREST SERVICE

Index File No. X-21

**CORNER RECORD (SEARCH)**

(Ref. FSM 7151.4)

Tract or Survey No. \_\_\_\_\_ Cor. No. \_\_\_\_\_


T 5S R 30E

R.D. N. FORK JOHN DAY County UMATILLA

Merid. WILLAMETTE

N.F. UMATILLA State OREGON

**CORNER DIAGRAM**

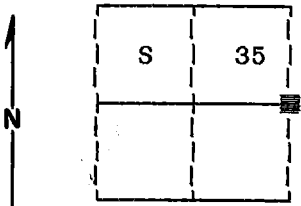

**DESCRIBE CORNER MONUMENT FOUND**

Found a 2½" brass cap monument marked as shown: in mound of stone.

T5S R30E  
 ¼  
 S 35 | S 36  
 1976  
 OPLS 598

**DESCRIBE BEARING TREES OR OTHER OFFICIAL ACCESSORIES FOUND**

Found a 24 inch diameter Ponderosa Pine N57°W, 34.3 ft. dead and down with scribes visible.  
 Found a 12 inch diameter Ponderosa Pine N26°E, 43.5 ft. live and vigorous with blaze evident.  
 Found a 12 inch diameter Ponderosa Pine S77°W, 42.3 ft. dead and standing with blaze evident.

**PHOTO IDENTIFICATION DATA**

Photo No. \_\_\_\_\_  
 Filed At. \_\_\_\_\_  
 Object Ident. \_\_\_\_\_  
 Ident. By \_\_\_\_\_  
 Signature \_\_\_\_\_

**DESCRIBE CORNER LOCATION RELATIVE TO NEAR-BY FEATURES, ALSO HOW TO REACH CORNER**

Corner falls on timbered South slope approximately 1800 feet South of the end of the 5309 road.

**PLANE COORDINATE POSITION DATA**

State \_\_\_\_\_ Zone \_\_\_\_\_  
 X \_\_\_\_\_  
 Y \_\_\_\_\_  
 Estab. By \_\_\_\_\_

Signature *[Handwritten Signature]* Agent

Title SURVEYOR

Division \_\_\_\_\_

Headquarters \_\_\_\_\_

Date 5-10-89

FS-7100-52 (3/68)

2

3

4

5

CORNER RECORD (PERPETUATION)

MONUMENT: DESCRIBE NEW MONUMENT SET, OR WORK DONE TO PRESERVE EXISTING MONUMENT

NONE

9

ACCESSORIES : DESCRIBE NEW BT'S WITNESS OBJECTS ETC. ESTABLISHED, OR WORK DONE TO PRESERVE EXISTING EVIDENCE

New Bearing Tree

A 10 inch diameter Ponderosa Pine bears N75°W, 20.43 feet marked ¼ S35 BT

Painted a 6 inch red band around all bearing trees and attached 54-3 and 54-9 signs.

Set a steel fencepost approximately 5 feet North with 54-9 and 54-2 signs attached.

10

Work Done By D. I. Griffith Title Surveyor Date 5-8-89 State Registration No. OPLS 644  
or Agency

Certified Cor. Record Prepared ?  Yes  No Filed At: Umatilla Co Surveyor Office Date 5-89

11

REMARKS

Witnesses: Rick Robinson and Jeff Peterson

12

Index File No. X-21 T.5S R.30E W.M. Tract or Surv. No. Cor.

13

Index File No. X-21

CORNER RECORD (SEARCH)

(Ref. FSM 7151.4)

Tract or Survey No. \_\_\_\_\_ Cor. No. X-21  
1/4


T 55 R. 30E

R.D. UKIAH County UMATILLA

Merid. WILLAMETTE

N.F. UMATILLA State OR

CORNER DIAGRAM

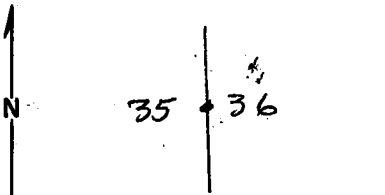

DESCRIBE CORNER MONUMENT FOUND

FD, BASALT STONE 12x10x8" MKD 1/4 ON W. FACE  
FIRMLY SET IN HD. OF STONE.

DESCRIBE BEARING TREES OR OTHER OFFICIAL ACCESSORIES FOUND

A 24" PINE SNAG BR. N57°W. 343 FT MKD 1/4 SBT.

PHOTO IDENTIFICATION DATA

Photo No. \_\_\_\_\_  
Filed At. \_\_\_\_\_  
Object Ident. \_\_\_\_\_  
Ident. By \_\_\_\_\_  
*Signature*

DESCRIBE CORNER LOCATION RELATIVE TO NEAR-BY FEATURES, ALSO HOW TO REACH CORNER

PLANE COORDINATE POSITION DATA

State \_\_\_\_\_ Zone \_\_\_\_\_  
X \_\_\_\_\_  
Y \_\_\_\_\_  
Estab. By \_\_\_\_\_  
*Agency*

Signature

*R.D. Barrett*

Title

*LAND SURVEYOR*

Division

Headquarters

Date

*9-30-76*

7100-52-(3/68)

## CORNER RECORD (PERPETUATION)

MONUMENT: DESCRIBE NEW MONUMENT SET, OR WORK DONE TO PRESERVE EXISTING MONUMENT

SET 2 1/2" x 30" IRON PIPE W/ BRASS CAP MKD.

T55 R30E

1/4

S35 | S36

1976

OPL5598

9

ACCESSORIES : DESCRIBE NEW BT'S WITNESS OBJECTS ETC. ESTABLISHED, OR WORK DONE TO PRESERVE EXISTING EVIDENCE

NEW BTA.

A 10" PINE BRS N26°E 435 FT MKD T55R30E 1/4 S36 BT.

A 10" PINE " S77°W 423 " " T55R30E 1/4 S35 BT.

10

Work Done By R.D. Baggett Title LAND SURVEYOR Date 9-30-76 State Registration No. OPL5598  
or AgencyCertified Cor. Record Prepared? Yes  No

Filed At:

Date

11

REMARKS

12

Index File No.

X-21

T.

R.

M.

Tract or Surv. No.

Cor.

13