

USDA-FOREST SERVICE

CORNER RECORD (SEARCH)

Index File No. Z-21

(Ref. FSM 7151.4)

Tract or Survey No. _____ Cor. No. _____

T 5S R. 30E

R.D. N. FORK JOHN DAY County


UMATILLA

Merid. WILLAMETTE

N.F. UMATILLA State

OREGON

CORNER DIAGRAM

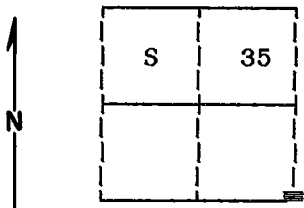

DESCRIBE CORNER MONUMENT FOUND

Found a 2½" brass cap monument marked as shown: in mound of stone.

T5S R30E
SC
3 . 3
T6S R30E
1977
PLS 933

2

DESCRIBE BEARING TREES OR OTHER OFFICIAL ACCESSORIES FOUND

Found a 14 inch diameter Douglas Fir N64°E, 76.3 ft. dead and standing with scribes visible.
Found a 12 inch diameter Ponderosa Pine N9°E, 66.7 ft. live and vigorous with scribes visible.

3

DESCRIBE CORNER LOCATION RELATIVE TO NEAR-BY FEATURES, ALSO HOW TO REACH CORNER

Corner falls on steep Southeast slope near top of rocky ridge approximately 500 feet East of clearcut.

4

PHOTO IDENTIFICATION DATA

Photo No. _____
Filed At. _____
Object Ident. _____
Ident. By _____
Signature _____

6

PLANE COORDINATE POSITION DATA

State _____ Zone _____
X _____
Y _____
Estab. By _____

7

Signature _____
Agent

Title
SURVEYOR

Division

Headquarters

Date
5-10-89

FS-7100-52 (3/68)

5

CORNER RECORD (PERPETUATION)

MONUMENT: DESCRIBE NEW MONUMENT SET, OR WORK DONE TO PRESERVE EXISTING MONUMENT

NONE

9

ACCESSORIES : DESCRIBE NEW BT's WITNESS OBJECTS ETC. ESTABLISHED, OR WORK DONE TO PRESERVE EXISTING EVIDENCE

New Bearing Object

A cliff 20 feet high and 60 feet long running Northeast-Southwest bears N33°E, 47.7 feet marked X B0

Painted a 6 inch red band around all bearing trees and attached 54-3 and 54-9 signs.

Set a steel fencepost approximately 5 feet North with 54-9 and 54-2 signs attached.

10

Work Done By D.I. Griffith Title Surveyor Date 5-9-89 State Registration No. or Agency OPLS 644

Certified Cor. Record Prepared? Yes No Filed At: Umatilla Co Surveyor Office Date 5-89

11

REMARKS

Witnesses: Rick Robinson and Jeff Peterson

12

Index File No. Z-21 T. 5S R. 30E W.M. Tract or Surv. No. Cor. 13

USDA-FOREST SERVICE

Index
File No. Z-21

CORNER RECORD (SEARCH)

(Ref. FSM 7151.4)

Tract or
Survey No. _____ Cor. No. _____


T 5S. R. 30E.

R.D. UR 138 County Umatilla

Merid. Willamette

N.F. Umatilla State Oregon

CORNER DIAGRAM

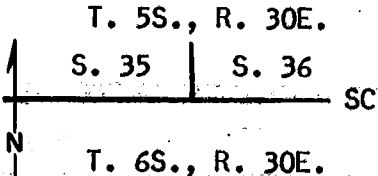

DESCRIBE CORNER MONUMENT FOUND

None

Set brass cap

DESCRIBE BEARING TREES OR OTHER OFFICIAL ACCESSORIES FOUND

None

PHOTO IDENTIFICATION DATA

Photo No. _____

Filed At. _____

Object Ident. _____

Ident. By _____

Signature

PLANE COORDINATE POSITION DATA

State _____ Zone _____

X _____

Y _____

Estab. By _____

Agency

DESCRIBE CORNER LOCATION RELATIVE TO NEAR-BY FEATURES, ALSO HOW TO REACH CORNER

From the intersection of U.S. Forest Roads 419N and 537N, go East about 1.8 miles to Gulliford crossing, then East about 2.2 miles to fence, then along fence 33.5 chns. to corner.

Signature
David H. Kunkle

Title _____ Division _____ Headquarters _____ Date _____

BPLS

933

7-77

7100-52-(3/68)

CORNER RECORD (PERPETUATION)

MONUMENT: DESCRIBE NEW MONUMENT SET, OR WORK DONE TO PRESERVE EXISTING MONUMENT

Set 2 1/2" x 30" iron pipe with brass cap
 Pipe is 19" in ground
 Mound of stone to cap

T. 5S., R. 30E.

SC

S.35 S.36

T. 6S., R. 30E.

1977

PLS 933

Stamped:

ACCESSORIES: DESCRIBE NEW BT'S WITNESS OBJECTS ETC. ESTABLISHED, OR WORK DONE TO PRESERVE EXISTING EVIDENCE

A 8" pine bears N. 08°45'E. 66.73 ft.

A 12" fir bears N. 64°33'E. 76.32 ft.

Set steel fence post 3 ft. East of corner w/sign.
 Painted red band around bearing trees w/sign.

10

Work Done By T. Hamby Title Party Chief Date 6/23/77 State Registration No. _____
 or Agency _____

Certified Cor. Record Prepared? Yes No Filed At: _____ Date _____

11

REMARKS

12

Index File No. T. R. M. Tract or Surv. No. Cor. 13