

OREGON CORNER RESTORATION FORM

Section 31 Township 5S Range 31E
 County Umatilla Date: 11-28-01

Corner Designation: 5S31Z1

Condition Report Only
 Not Found
 Remonumented
 Unrecorded
 Surveyed In
 Referenced Out


Previous Renewals / Surveys, etc.

A copy of a Certified Record of Land Corner Monumentation was obtained from David Schlaich of the Umatilla National Forest. It reads: Found stone 6"x 12"x17" set in a mound of stone, no mks visible. Set on south face of bluff. From which: a dead and down 23" pine bears N.71°E., 70.6'. mkd T5S R31E S31 SC BT (Orig. BT). No evidence of the other BT was found. At the corner point: Set a 2 1/2" x 30" iron pipe 18" in ground. From which I scribe new bearing trees: A 31" pine brs. N.30°E., 141.0 ft. mkd T5S R31E S31 SC BT. An 18" pine brs. N.47°W., 95.4ft. mkd T5S R30E S36 SC BT. Raised mound of stone 3' base to top of pipe.


Monument and Accessories Found: (condition and source)

Found the corner as described above except the 31" pine ZN30°E is now dead and down.

DIAGRAM

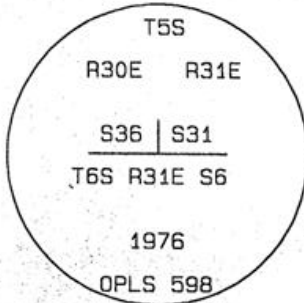

SKETCH

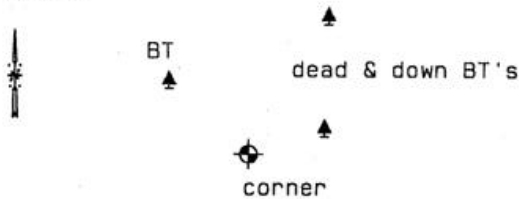

MONUMENT (S) AND ACCESSORIES SET (Procedures and Description)

None.

REFERENCES SET:

None.

Made GPS tie to TRI Station FORE.	Oregon State Plane Coord. - North Zone
Latitude 45°04'59.10910"N	Northing 519870.21
Longitude 119°01'24.34330"W	Easting 8583451.42
NAD 83(1991)	Ortho Height 3579.51
	Ellipsoidal Height 3520.03

Location and Comments	Compass Declination	Surveyors Seal
From junction Highways 395 and 244, go south on Highway 395 6 miles to junction Fivemile creek road., follow Fivemile road 1 mile to washout. Walk up road 2.0 miles. From cruiser tag, go north uphill 500' to corner.	20°E	

RECEIVED BY:

Date: 01-02
 Rec'd By: KK
 No. 02-06-R

Firm / Agency

Haddock Surveying
 P. O. Box 1574
 Pendleton, OR 97801
 (541) 276-2174

REGISTERED
 PROFESSIONAL
 LAND SURVEYOR

David L. Haddock

OREGON
 JULY 12, 1968
 DAVID L. HADDOCK
 852