

Index J-9  
File No. \_\_\_\_\_

CORNER RECORD (SEARCH)

Tract or  
Survey No. \_\_\_\_\_

Cor. 22 14  
No. 8-9


T 5S R. 31E

R.D. Ukiah County Umatilla

Merid. Willamette

N.F. Umatilla State Oregon

CORNER DIAGRAM

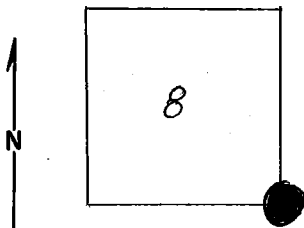

~~DESCRIBE CORNER MONUMENT FOUND~~ *Original notes*

set basalt stone 18x10x6 on E. slope in mound of stone for cor. to sec. 8-9-16-17

*Monumented by BLM in 1978*

~~DESCRIBE BEARING TREES OR OTHER OFFICIAL ACCESSORIES FOUND~~

pine 8" dia. brs. N22E 112 lks dist  
pine 36" dia. brs. S64W 70 lks dist.  
pine 30" dia. brs. N24W 90 lks dist.

PHOTO IDENTIFICATION DATA

Photo No. \_\_\_\_\_  
Filed At. \_\_\_\_\_  
Object Ident. \_\_\_\_\_  
Ident. By \_\_\_\_\_  
*Signature*

PLANE COORDINATE POSITION DATA

State \_\_\_\_\_ Zone \_\_\_\_\_  
X \_\_\_\_\_  
Y \_\_\_\_\_  
Estab. By \_\_\_\_\_  
*Agency*

DESCRIBE CORNER LOCATION RELATIVE TO NEAR-BY FEATURES, ALSO HOW TO REACH CORNER

Located old fence line running W followed to fence that runs N&S. Found 3BT that corresponds with original notes. Two of BT had been cut down but we could still see some of the inscribing on the tree in sec. 8-17-. The BT in sec. 9 had Form 458 on it and a blaze mark. Couldn't read the inscribing. Chained to the stumps and the dist. corresponds with original notes. In company with R. Swainston.

Signature

Title

Division

Headquarters

Date

7100-52

*1st V. H. AVERETT*

*Eng Aide.*

*3-31-65*

REV. 65 5

**CORNER RECORD (PERPETUATION)**

**MONUMENT: DESCRIBE NEW MONUMENT SET, OR WORK DONE TO PRESERVE EXISTING MONUMENT**

9

**ACCESSORIES DESCRIBE NEW BT's WITNESS OBJECTS ETC. ESTABLISHED, OR WORK DONE TO PRESERVE EXISTING EVIDENCE**

10

Work Done By \_\_\_\_\_ Title \_\_\_\_\_ Date \_\_\_\_\_ State Registration No. or Agency \_\_\_\_\_  
Certified Cor. Record Prepared ? Yes No Filed At: \_\_\_\_\_ Date \_\_\_\_\_

11

**REMARKS**

12

Index File No. J-9 T. R. M. Tract or Surv. No. Cor. 13