

Index  
File No. W-16


**CORNER RECORD (SEARCH)**  
(Ref. FSM 7.151.4)

Tract or  
Survey No. \_\_\_\_\_ Cor.  
No. \_\_\_\_\_

T 55 R. 32E  
Merid. WILLAMETTE

R.D. UKIAH County UMATILLA  
N.F. UMATILLA State OREGON

**CORNER DIAGRAM**

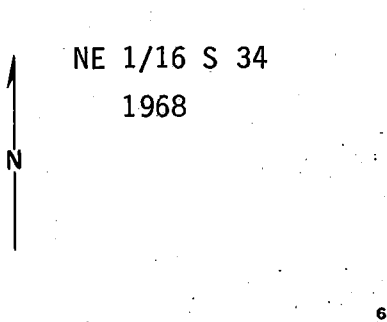

**DESCRIBE CORNER MONUMENT FOUND**

Found an iron pipe, firmly set,  
2½ ins. diam., with brass cap  
mkd.

U.S. Dept. of Interior  
Bureau of Land Management  
NE 1/16 S 34  
1968

**DESCRIBE BEARING TREES OR OTHER OFFICIAL ACCESSORIES FOUND**

A Ponderosa Pine, 8 ins. diam., bears S. 11½° E., 22 lks. dist.,  
mkd. NE 1/16 S34 BT. (1980)

A Douglas Fir, 10 ins. diam., bears S. 74° W., 46 lks. dist., mkd.  
NE 1/16 S34 BT. (1980)

**PHOTO IDENTIFICATION DATA**

Photo No. \_\_\_\_\_  
Filed At. \_\_\_\_\_  
Object Ident. \_\_\_\_\_  
Ident. By \_\_\_\_\_  
*Signature*

Both BT's alive with partially healed blazes.

**DESCRIBE CORNER LOCATION RELATIVE TO NEAR-BY FEATURES, ALSO HOW TO REACH CORNER**

**PLANE COORDINATE POSITION DATA**

State \_\_\_\_\_ Zone \_\_\_\_\_  
X \_\_\_\_\_  
Y \_\_\_\_\_  
Etab. By \_\_\_\_\_  
*Agency*

\_\_\_\_\_

*Signature*

Title LS 1099 Division \_\_\_\_\_ Headquarters \_\_\_\_\_ Date 9-17-84 FS-7100-52 (3/68)

CORNER RECORD (PERPETUATION)

MONUMENT: DESCRIBE NEW MONUMENT SET, OR WORK DONE TO PRESERVE EXISTING MONUMENT

None

ACCESSORIES: DESCRIBE NEW BT'S, WITNESS OBJECTS ETC. ESTABLISHED, OR WORK DONE TO PRESERVE EXISTING EVIDENCE

Note that the SW BT is a Douglas Fir, not a Pine as stated in the BLM Record.

Work Done By: Gary Langlitz Title LS 1099 Date 8-84 State Registration No. or Agency

Certified Cor. Record Prepared? (Yes) No Filed At: UMATILLA CO. SURVEYOR Date 9-84

REMARKS

Index File No. W-16 T. 5S R. 32E M. WILLAMETTE Tract or Surv. No. Cor.