

USDA-FOREST SERVICE

Index

File No. Z-21

CORNER RECORD (SEARCH)

(Ref. FSM 7151.4)

Tract or Survey No. _____

Cor. No. _____

T 5S R. 32E

R.D. Ukiah


County Umatilla

Merid. Willamette

N.F. Umatilla

State Oregon

CORNER DIAGRAM

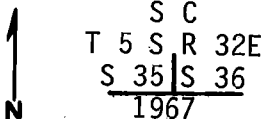

DESCRIBE CORNER MONUMENT FOUND

Found an iron pipe, firmly set, 2½ ins. diam., 6" above ground, with brass cap mkd,

U.S. Dept. of Interior
Bureau of Land Management

S C
T 5 S R 32E
S 35 | S 36
1967

DESCRIBE BEARING TREES OR OTHER OFFICIAL ACCESSORIES FOUND

An Engleman Spruce, 23 ins. diam., bears N. 33° E., 65½ lks. dist.,
A White Fir, 12 ins. diam., bears N. 77° W., 27½ lks. dist.,
Both BT's in good condition with well-healed single blazes.

PHOTO IDENTIFICATION DATA

Photo No. 280-232
Filed At. UMATILLA NAT. FOR.
Object Ident. DIRECT.
Ident. By J. J. [Signature]
signature

DESCRIBE CORNER LOCATION RELATIVE TO NEAR-BY FEATURES, ALSO HOW TO REACH CORNER

Corner located 2 ft. south of an East-West fence.

PLANE COORDINATE POSITION DATA

State _____ Zone _____
X _____
Y _____
Estab. By _____
Agency

Jay L. [Signature]
Signature

Title
LS 1099

Division

Headquarters

Date
9-17-84

7100-52-(3,68)

CORNER RECORD (PERPETUATION)

MONUMENT: DESCRIBE NEW MONUMENT SET, OR WORK DONE TO PRESERVE EXISTING MONUMENT

None

ACCESSORIES: DESCRIBE NEW BT'S WITNESS OBJECTS ETC. ESTABLISHED, OR WORK DONE TO PRESERVE EXISTING EVIDENCE

None

Work Done By Gary Langlitz Title Land Surveyor Date 8-84 State Registration No. 1099
or Agency

Certified Cor. Record Prepared? Yes No Filed At: _____ Date _____

REMARKS


Index File No. Z-21 T. 5S R. 32E M. Willamette Tract or Surv. No. _____ Cor. _____

LAND CORNER RECORD

5680-2

1. T 55 R 32E No. 2-21 Cor. Sec Mer. Will State OREGON (Rectangular) N. F. _____ Dist. Union

2. Corner Status

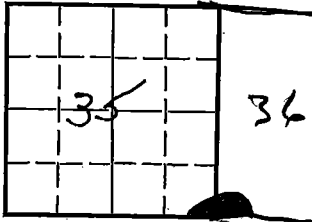

3. Original Description _____ Vol. _____ Page _____ Where Recorded _____

4. Description of Corners: Bross Cap Set by BLM 1967

5. Investigation Notes:

7. Photo Identification

Photo No. _____

Ident. By: _____

8. Plane Coordinate Position Data

State _____ Zone _____

X _____

Y _____

Estab. By _____

Field Book No. _____

Where Filed _____

9. Evaluation

Authentic _____

Needs Verif. _____ Monument _____

Re-estab. _____ Survey _____

Land Status _____

6. Signed Tom L. Roney Title S.O. Date 12-19-67

PERPETUATION RECORD

10. Monument:

11. Accessories

Field Book _____ Page _____

12. Set By _____ Title _____

License _____ Agency _____ Date _____

13. Recorded By _____ Volume _____ Page _____
(Agency)

(Date) (City) (County) (State)

14. Remarks:

Z-21