


Index
File No. 2-6
T 5S R. 32E
Merid. WILLAMETTE

CORNER RECORD (SEARCH)
(Ref. FSM 7151.4)
R.D. UKIAH County UMATILLA
N.F. UMATILLA State OREGON

Tract or
Survey No. _____
Cor.
No. _____

CORNER DIAGRAM

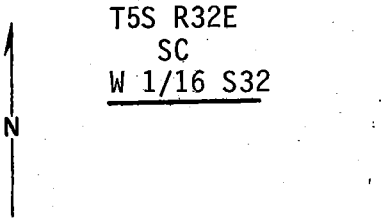

DESCRIBE CORNER MONUMENT FOUND

Found a 2½" dia. iron pipe, firmly set in a mound of stone as described in the BLM record, with brass cap attached, marked:

U.S. Dept. of the Interior
Bureau of Land Management

SC
W 1/16 S32
1968

DESCRIBE BEARING TREES OR OTHER OFFICIAL ACCESSORIES FOUND

The only BT as marked by BLM, a 15" Ponderosa Pine, alive and well-healed bears N 57°W 30.9 feet.

PHOTO IDENTIFICATION DATA

Photo No. _____
Filed At. _____
Object Ident. _____
Ident. By _____
Signature

DESCRIBE CORNER LOCATION RELATIVE TO NEAR-BY FEATURES, ALSO HOW TO REACH CORNER

PLANE COORDINATE POSITION DATA

State _____ Zone _____
X _____
Y _____
Estab. By _____

Ray J. Langley
Signature

Title LS 1099 Division _____ Headquarters _____

Date 9-18-84 FS-7100-52 (3/68)

CORNER RECORD (PERPETUATION)

MONUMENT: DESCRIBE NEW MONUMENT SET, OR WORK DONE TO PRESERVE EXISTING MONUMENT

None

ACCESSORIES: DESCRIBE NEW BT'S WITNESS OBJECTS ETC. ESTABLISHED, OR WORK DONE TO PRESERVE EXISTING EVIDENCE

We mark a new bearing tree, a 10" Ponderosa Pine, scribed "W 1/16 S32 BT" on a double blaze, Bears N 76°E 103.9 ft. Attached brass washer marked "LS 1099" to lower blaze of new BT.

Work Done By Gary Langlitz Title LS 1099 Date 8-84 State Registration No. _____
or Agency _____

Certified Cor. Record Prepared Yes No Filed At: UMATILLA CO. SURVEYOR Date 9-84

REMARKS

Magnetic Compass (20° East Declination)
Steel Tape

Index File No. Z-6 T. 5S R. 32E M. WILLAMETTE Tract or Surv. No. _____ Cor. _____