


Index
File No. H-9
T 59 R. 34E
Merid. WILLAMETTE

CORNER RECORD (SEARCH)
(Ref. FSM 7151.4)

R.D. LA GRANDE County Union Tract or Survey No. _____ Cor. No. 1/4
N.F. W-W State OREGON 1/4 COR. of Sect.
8 & 9

CORNER DIAGRAM

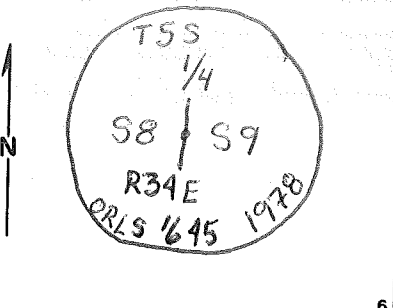

DESCRIBE CORNER MONUMENT FOUND 2 1/2" GALV. PIPE w/ 3" BRASS
CAP

DESCRIBE BEARING TREES OR OTHER OFFICIAL ACCESSORIES FOUND 2
13" DF BT IS THE ONLY BT LEFT AT THIS CORNER
N58°E 9'8 FT
3 NEW BTS SHOULD BE ESTABLISHED
REPAINTED BLAZES & 6" RED BANDSON REMAINING BTS

PHOTO IDENTIFICATION DATA 6
Photo No. _____
Filed At. _____
Object Ident. _____
Ident. By _____
Signature _____ 7

DESCRIBE CORNER LOCATION RELATIVE TO NEAR-BY FEATURES, ALSO HOW TO REACH CORNER 3

PLANE COORDINATE POSITION DATA
State _____ Zone _____
X _____
Y _____
Estab. By _____
Agency _____ 8

Signature EARL E. STRANG Title CET Division LLL Headquarters GREZ Date 7/26/93 4
7100-52-(3/68) 5

CORNER RECORD (PERPETUATION)

MONUMENT: DESCRIBE NEW MONUMENT SET, OR WORK DONE TO PRESERVE EXISTING MONUMENT

ACCESSORIES : DESCRIBE NEW BT'S WITNESS OBJECTS ETC. ESTABLISHED, OR WORK DONE TO PRESERVE EXISTING EVIDENCE

Work Done By _____ Title _____ Date _____ State Registration No. or Agency _____
Certified Cor. Record Prepared? Yes No Filed At: _____ Date _____

REMARKS

Index File No. H-9 T. 55 R. 34E M. WM Tract or Surv. No.


1/4 Cor. OF
SECT. 8 & 9

Index
 File No. H-9
 T 5 S R. 34 E
 Merid. Willamette

CORNER RECORD (SEARCH)
 (Ref. FSM 7151.4)

R.D. LaGrande County Union Tract or Survey No. _____
 N.F. WW-16 State Oregon Cor. No. S-1/16

CORNER DIAGRAM

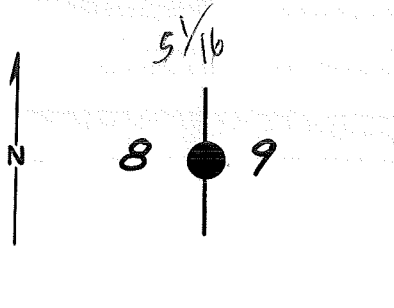

DESCRIBE CORNER MONUMENT FOUND

None

DESCRIBE BEARING TREES OR OTHER OFFICIAL ACCESSORIES FOUND

None

PHOTO IDENTIFICATION DATA

Photo No. _____
 Filed At. _____
 Object Ident. _____
 Ident. By _____
Signature

DESCRIBE CORNER LOCATION RELATIVE TO NEAR-BY FEATURES, ALSO HOW TO REACH CORNER

Approx. 60 ft. S of existing fence corner.

PLANE COORDINATE POSITION DATA

State _____ Zone _____
 X _____
 Y _____
 Estab. By _____
Agency

Signature
Hambleton

Title

Division
ORLS

Headquarters
645

Date
8-78

7100-52-(3/68)

CORNER RECORD (PERPETUATION)

MONUMENT: DESCRIBE NEW MONUMENT SET, OR WORK DONE TO PRESERVE EXISTING MONUMENT

Set a 2 $\frac{1}{2}$ " x 30" iron pipe w/brass cap mkd.:
Buried in large mound of stone and dirt.

T 5 W 5
S-1/16
S 8 | S 9
R 34 E
1978
ORLS 645

9

ACCESSORIES : DESCRIBE NEW BT'S WITNESS OBJECTS ETC. ESTABLISHED, OR WORK DONE TO PRESERVE EXISTING EVIDENCE

5" ^{L.P.} pine bears S 62 W, 41.98 ft. scribed 1/16 S 8 BT.
6" ^{L.P.} pine bears S 53 E, 62.94 ft. scribed 1/16 S 9 BT.
Painted blaze and band of BT's red & yellow. Tagged trees w/54-3&4 signs.
Set steel fence post by mound of stone w/signs 54-4, 6&9.

10

Work Done By J. Hambleton Title Surveyor Date 8-78 State Registration No. ORLS 645
or Agency

Certified Cor. Record Prepared? Yes No Filed At: Union CS Date

11

REMARKS

Witnesses: L. Green
L. Shirley

Index File No. T. R. M. Tract or Surv. No. Cor.

12

13