

OREGON CORNER RESTORATION FORM

Section 23 Township 6N Range 33E
 County Umatilla Date: April 01, 2003

Corner Designation: 6N33R21

Corner to sections 23, 24, 25, and 26, T6N, R33E,
 W.M., Umatilla County, Oregon.


Condition Report Only
 Not found
 Remonumented
 Unrecorded
 Surveyed in
 Referenced out

Previous Renewals / Surveys, etc.

Corner originally set by Nicholas O. Walden under Contract No. 209 dated July 6th, 1874. His record reads: Set alder post, 4 ft long, 4 ins. diam. Drove Charred Stake & raised mound of earth with pits, etc., as per instructions, for Cor. to Secs. 23, 24, 25 & 26. This corner was visited by John Kimbrell under the survey recorded in Book 2, Page 250 of the record of private surveys. Mr. Kimbrell did not identify the monument and does not say he set anything.

Monument and Accessories found: (condition and source)

A fence corner with fences running North, East and South. The fences had been recently removed and the posts burnt at this point.

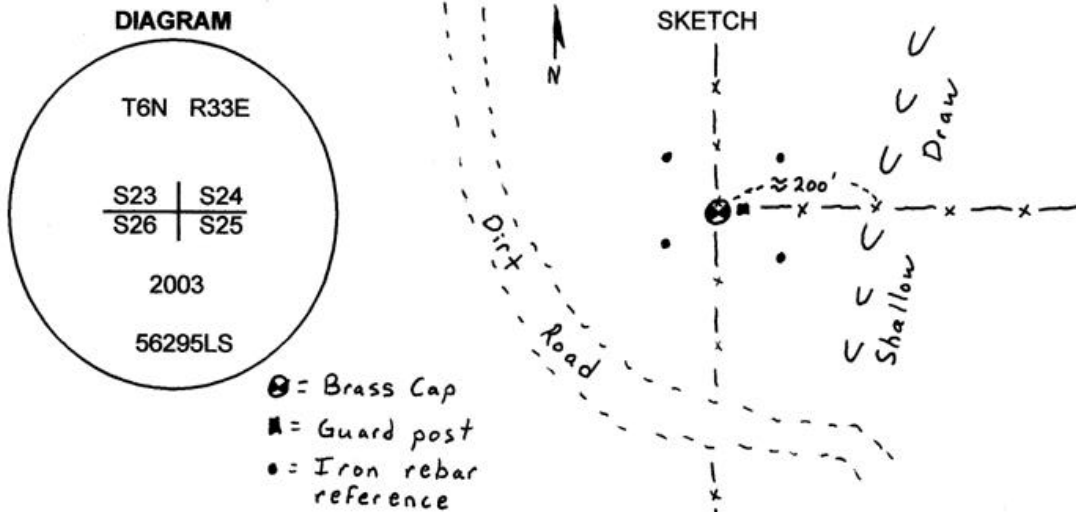

MONUMENT (S) AND ACCESSORIES SET (Procedures and Description)

I set a 1 1/2" x 30" galvanized iron pipe with a 2 1/4" Brass cap stamped as shown in the diagram above at the fence intersection. I set a 5' steel guard post with a County monument sign attached along side.

For references, I set four, 5/8" by 24" green coated, iron rebars with 1.25" orange plastic caps stamped WTS and 56295LS attached as described below:

- a rebar bears N51°38'04"E, 27.27 feet;
- a rebar bears N46°56'48"W, 30.55 feet;
- a rebar bears S44°46'28"W, 26.93 feet;
- a rebar bears S46°42'31"E, 32.40 feet;

The monument and references were tied using a LIECA system 300 RTK GPS.

Location and comments
 NAD 83-91 coordinates from a single
 GPS tie to Tri Station GEER.

N 846936.75
 E 8674356.89
 RECEIVED BY:
Umatilla County Surveyor
 Date: 11-03
 Rec'd By: KK
 No. 03-315-C

Compass Declination
 Firm / Agency
 Witness Tree Surveying
 Address
 P.O. Box G
 Pilot Rock, Or. 97868
 Party Chief
 Stephen K, Haddock

Surveyors Seal

REGISTERED
 PROFESSIONAL
 LAND SURVEYOR

Stephen K. Haddock

OREGON
 JULY 9, 2001
 STEPHEN K. HADDOCK
 56295LS

RENEWAL DATE 6-30-05