

OREGON CORNER RESTORATION FORM

Section 19 Township 6N Range 35E
County UMATILLA Date 4/10/03

CORNER DESIGNATION

N-3

- Condition Report Only
- Not Found
- Renewed
- Unrecorded
- Surveyed In
- Referenced Out

Previous Renewals/Surveys, etc.:

ODELL AND LEWIS DROVE A CHARRED STAKE, DUG PITS, AND RAISED A MOUND, CONTRACT NO. 110, DATED FEBRUARY 7, 1865. WAYNE HARRIS FOUND AN IRON PIPE, ORIGIN UNKNOWN, SURVEY 93-40-B.


Monument (s) & Accessories Found: (Condition and Source)

FOUND AND ACCEPTED A 1" O.D. IRON PIPE 8" BELOW THE SURFACE OF GRABNER LANE.

Monument Detail

Sketch

NOT TO SCALE

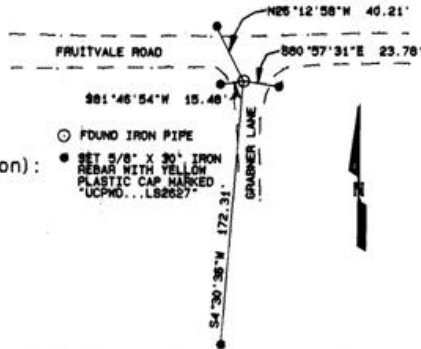

Monument Set (Procedures and Description):

NONE

New Accessories:

- A 5/8" iron rebar with yellow plastic cap marked "UCPWD...LS2627" bears N26°12'58"W, 40.21' (A wood fence post with bearing object tag bears west 1.3' from pin).
- A 5/8" iron rebar with yellow plastic cap marked "UCPWD...LS2627" bears S80°57'31"E, 23.78' (A metal sign post with bearing object tag bears northeast 0.6' from pin).
- A 5/8" iron rebar with yellow plastic cap marked "UCPWD...LS2627" bears S4°30'36"W, 172.31' (A PP&L pole with bearing object tag bears northwest 1.5' from pin).
- A 5/8" iron rebar with yellow plastic cap marked "UCPWD...LS2627" bears S81°46'54"W, 15.48' (A PP&L pole with bearing object tag bears north 0.9' from pin).

Location and Comments: Compass Declination: N/A Surveyor's Seal

From the intersection of State Highway 332 and Fruitvale Road, travel approximately 1/2 mile east to a gravel road leading south (Grabner Lane). The corner is approximately 8" below the surface of Grabner Lane and lies south of Fruitvale Road

Firm/Agency :
UMATILLA COUNTY
ROAD DEPARTMENT

Address:
3920 WESTGATE
PENDLETON, OREGON 97801

Party Chief:
GARY ROBERTS

Notes:
GARY ROBERTS

Witness:
NONE

REGISTERED PROFESSIONAL LAND SURVEYOR

Doug K. Roberts

OREGON
JULY 20, 1993
GARY R. ROBERTS
2627
RENEWS 12/31/2004

OREGON STATE PLANE COORDINATES
NAD '83(91) NORTH ZONE 3601 (INTERNATIONAL FEET)

NORTHING: 853,931.27
EASTING: 8,713,840.39

RECEIVED BY

Umatilla County Surveyor

Date 4-03

Rec'd By KK

No. 03-59-B