

OREGON CORNER RESTORATION FORM

Section 30 Township 6N Range 35E
 County UMATILLA Date 4/10/03

CORNER DESIGNATION

T-5

- Condition Report Only
- Not Found
- Renewed
- Unrecorded
- Surveyed In
- Referenced Out


Previous Renewals/Surveys, etc.:

Odell and Lewis, under Contract No. 110, dated February 7, 1865, drove charred stake, dug pits, and raised mound. Bartleson found square iron bar he described as a road P.I.. Survey No. 97-207-B. He and others have used a single proportion location for the 1/4 Corner.


Monument(s) & Accessories Found: (Condition and Source)

Found a 1" square iron bar (no record) and accepted its location due to its relationship to Phillips Road, a plow line to the east, and an east-west fence line to the south.

Monument Detail

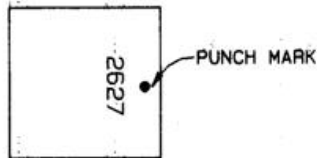

Sketch
NOT TO SCALE

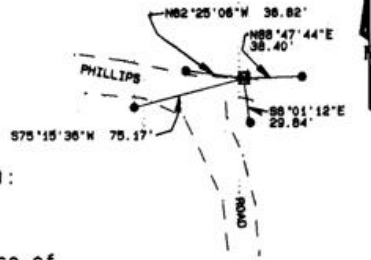

Monument Set (Procedures and Description):

No new monument was set. The iron bar was driven to a point 4' below the surface of a field access road and stamped as shown above.

- FOUND 1" SQUARE IRON BAR
- SET 5/8" X 30" IRON REBAR WITH YELLOW PLASTIC CAP MARKED "UCPWD...LS2627"

New Accessories:

A 5/8" iron rebar with yellow plastic cap marked "UCPWD...LS2627" bears S75°15'36"W, 75.17'.

A 5/8" iron rebar with yellow plastic cap marked "UCPWD...LS2627" bears N82°25'06"W, 38.82'.

A 5/8" iron rebar with yellow plastic cap marked "UCPWD...LS2627" bears S8°01'12"E, 29.84' (a metal fence post with bearing object tag bears 0.7' southeast from pin).

A 5/8" iron rebar with yellow plastic cap marked "UCPWD...LS2627" bears N88°47'44"E, 38.40' (a 3" diameter iron pipe protruding 3.3' above ground with bearing object tag bears 0.9' northeast from pin).

Location and Comments: Compass Declination: N/A

From the intersection of Phillips Road and Ringer Road in Umapine, travel east on Phillips Road for approximately 3/4 mile, then south for 1/4 mile, then east 1/4 mile to the corner, which is a 1" square iron bar buried approximately 4" below the surface of a dirt field access.

Firm/Agency :
 Umatilla County
 Road Department
 Address:
 3920 Westgate
 Pendleton, Oregon 97801
 Party Chief:
 Gary Roberts
 Notes:
 Gary Roberts
 Witness:
 None

Surveyor's Seal

REGISTERED
 PROFESSIONAL
 LAND SURVEYOR

Gary R. Roberts
 OREGON
 JULY 20, 1993
 GARY R. ROBERTS
 2627

RENEWS 12/31/2004

OREGON STATE PLANE COORDINATES
 NAD '83 (91) NORTH ZONE 3601 (INTERNATIONAL FEET)
 NORTHING: 845,910.78
 EASTING: 8,716,770.36

RECEIVED BY

Umatilla County Surveyor
 Date 4-03
 Rec'd By KK
 No. 03-59-B