

OREGON CORNER RESTORATION FORM

COUNTY: Umatilla DATE: 05/28/2014

CORNER DESIGNATION: L-25 and L-1

Quarter Corner common to Section 13 L-25 S13T6NR37E and Section 18 L-1 S18T6NR37E,
Township 6 North, Range 37E and 38E, W.M.

PREVIOUS RENEWALS/SURVEYS ETC:

Originally surveyed by William H. Odell and William S. Lewis, Deputy Surveyors, Contract No. 110, dated February 7, 1865, their note states "Set post for the ¼ Sec. Cor. from which:
A fir 6 ins. diam. bears N 15°W., 21 lks. dist.

Surveyor Wayne O. Harris noted in his June 27, 1961 survey, shown on Umatilla County Survey, record of surveys 03-291-A (Drawing Number 61-112-C), "Set steel stake, 14" Douglas fir S82°E-27.0"

Per the United States Department of the Interior Bureau of Land Management Survey and notes dated June 25, 1993, and executed by Richard L. Johnson, Phillip G. Griffin, Larry D. Holmes and Richard R. Shatto, Cadastral Surveyors, beginning October 13, 1987 and completed September 16, 1991 pursuant to Special instruction dated September 18, 1987 and Supplemental Special Instructions dated May 9, 1990, under Group Number 1405, Oregon, there notes state "Point for the ¼ sec. cor. of secs. 13, and 18, at proportionate distance; there is no remaining evidence of the original corner. Set a stainless steel post, 28 ins. long, 2½ ins. diam., 24 ins. in the ground, with a brass cap mkd.

T6N
¼
R37E R38E
S 13 | S 18
1991

from which:

A fir, 29 ins. diam., bears N. 58° E., 52 lks. dist., mkd ¼ S18 BT.

A fir, 15 ins. diam., bears S. 49¾° W., 36 lks. dist., mkd ¼ S13 BT.

Deposited a white "Deep-1" magnet marker at base of stainless steel post.

The corner is located on steep NE slope.

From this point, a point re-established as the ¼ sec. cor. of secs. 13 and 18, recorded by Wayne O. Harris, Registered Land Surveyor No. 346, in 1960, in Umatilla County Surveyor's Office, bears N. 16° 51' 30" E., 0.450 chs. dist., monumented with an iron rod, 1 in, square, firmly set, protruding 4 ins. above the ground. This point is not properly positioned and is not utilized in this survey, from which a bearing tree mkd. by Harris:

A fir 19 ins. diam., bears S. 82 E., 41½ lks. dist., with healed blaze

Creek, dry 20 lks. wide, drains S. 75°E., over level ground.

Dirt road, 15 lks. wide, bears N. 75° W. and S. 75° E.; asc. steep rocky S. slope.

Intersect the Oregon and Washington State bdy. and true point for the closing cor. of secs. 13 and 18.

Surveyor Wayne O. Harris noted in his June 27, 1961 survey, shown on Umatilla County Survey, record of surveys 03-291-A (Drawing Number 61-112-C), "Set steel stake 14" D. fir S82°W-27.0"

MOUNUMENT AND ACCESSORIES FOUND:

Found a 3" brass cap on a 2½" stainless steel pipe.

Found 1" square iron rod bears N15°E 29.8 feet, bears sign marked T6NR38ES18 BO, re-established by Wayne Harris in 1960 per CS 03-291-A.

Found 30" diam. fir bears N57°E 35.5 feet marked T6NR38ES18BT.

Found 21" diam. fir bearing S47°W 23.8 feet marked T6NR37ES13BT

MOUNUMENT MARKING DETAIL:

T6N
¼
S13 | S18
R37E | R38E
1991

MOUNUMENT AND ACCESSORIES SET:

Set ½ inch iron rebar with red cap marked "TLS/HDJ" Bearing N84°W 29.7 attached a bearing sign marked: T6NR37ES13BO in 1.5 feet rock mound.

LOCATION AND COMMENTS:

Bearings taken with Silva hand compass and distances measured with a steel tape.

OREGON STATE PLANE COORDINATE, North Zone, NAD 83(91), International Feet:

N = 859066.82

E = 8806087.25


COMPASS DECLINATION: 15° East

SURVEYORS' SEAL:

FIRM: HDJ Design Group
5 N. Colville
Walla Walla WA 99362

WITNESSES: Joseph R. Latimer
Felipe G. Hernandez

REGISTERED
PROFESSIONAL
LAND SURVEYOR

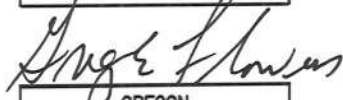

OREGON
JUNE 30, 1997
GREG E. FLOWERS
02820LS

RENEWS 12/31/15

06/29/2015

15-063-C