

USDA-FOREST SERVICE

Index File No. ~~XXXX~~ (N 1/2 1.10)

CORNER RECORD (SEARCH)


(Ref. FSM 7151.4)

Tract or Survey No. \_\_\_\_\_

Cor. No. WNV

T 6 N R. 39 E R.D. W W County UMATILLA  
Merid. Will. N.E. UMATILLA State ORE.

CORNER DIAGRAM

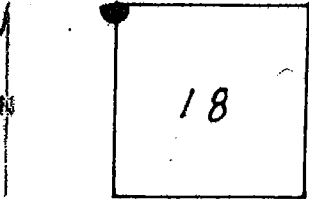

DESCRIBE CORNER MONUMENT FOUND

Brass Cap: 4" DIA., 18" above ground, condition good.  
marked: U.S. General Land Office Survey  
T6N CC 1932 R38E R39E S13 S18

DESCRIBE BEARING TREES OR OTHER OFFICIAL ACCESSORIES FOUND

Red paint ring on one tree in each section about 4 feet above ground.

PHOTO IDENTIFICATION DATA


Photo No. \_\_\_\_\_  
Filed At. \_\_\_\_\_  
Object Ident. \_\_\_\_\_  
Ident. By \_\_\_\_\_

Signature

PLANE COORDINATE POSITION DATA

State \_\_\_\_\_ Zone \_\_\_\_\_  
X \_\_\_\_\_  
Y \_\_\_\_\_  
Etab. By \_\_\_\_\_  
Agency \_\_\_\_\_

DESCRIBE CORNER LOCATION RELATIVE TO NEAR-BY FEATURES, ALSO HOW TO REACH CORNER

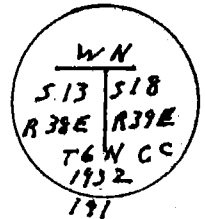

Signature

Title

Division

Headquarters

Date 1982 7100-52-(3/68)

CORNER RECORD (PERPETUATION)

MONUMENT: DESCRIBE NEW MONUMENT SET, OR WORK DONE TO PRESERVE EXISTING MONUMENT

ACCESSORIES: DESCRIBE NEW BT'S WITNESS OBJECTS ETC. ESTABLISHED, OR WORK DONE TO PRESERVE EXISTING EVIDENCE

Work Done By \_\_\_\_\_ Title \_\_\_\_\_ Date \_\_\_\_\_ State Registration No. or Agency \_\_\_\_\_

Certified Cor. Record Prepared? Yes No Filed At: \_\_\_\_\_ Date \_\_\_\_\_

REMARKS