


History of original corner establishment:

Unsurveyed - subdivided section

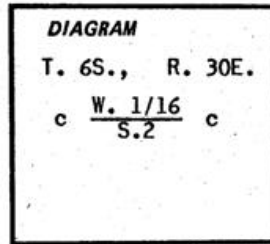

No record of subsequent remonumentation found in County Record.

Description of corner evidence found:


None.

Description of monument and accessories I established to perpetuate the original location of this corner:

Set 2 1/2" x 30" iron pipe 26" in ground with brass cap marked as shown: From which I scribed Bearing Trees.

A 9" pine bears N. 48°21' W. 41.0 ft. mkd. CW 1/16 S.2 BT.
 A 8" fir bears S. 21°56' E. 22.1 ft. mkd. CW 1/16 S.2 BT.

Nailed a brass washer mkd. PLS 933 to the BT blaze of both trees. Set fence post 2 ft. East of corner. Used transit and steel tape, measuring to the center of BTs.

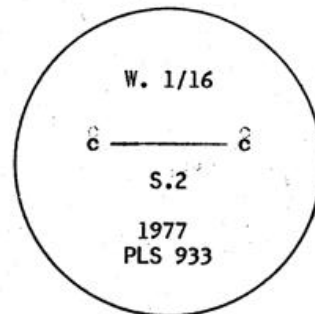

Office of.....County Surveyor..... County of.....Umatilla.....
 State of.....Oregon....., I hereby certify that the within instrument was filed in this office
 for record on the..... day of....., 19.....
David H. Krumbein by.....
 (COUNTY OFFICIAL) (DEPUTY)

A-18