


History of original corner establishment:

Unsurveyed - subdivided section

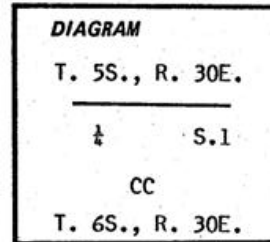

No record of subsequent remonumentation found in County Records.

Description of corner evidence found:


None.

Description of monument and accessories I established to perpetuate the original location of this corner:

Set 2½" x 30" iron pipe 28" in ground with brass cap marked as shown: From which I scribed Bearing Trees.

A 21" fir bears S. 68°28' E. 23.0 ft. mkd. T. 6S., R. 30E. ¼ S.1 BT.
A 29" pine bears S. 73°28' W. 55.7 ft. mkd. T. 6S., R. 30E., ¼ S.1 BT.

Nailed brass washer mkd. PLS 933 to the BT blaze of both trees. Set a steel fence post 3 ft. East of corner. Corner is 130 ft. North of E-W road and 180 ft. North of E-W fence line. Used transit and steel tape; measuring to the center of BTs.

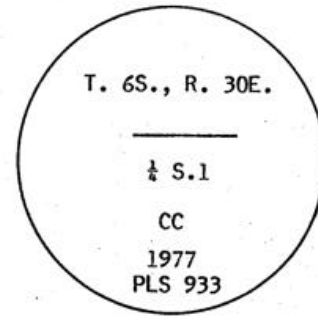

Office of..... County Surveyor County of..... Umatilla

State of..... Oregon, I hereby certify that the within instrument was filed in this office
for record on the..... day of....., 19.....

M. C. Harris by
(COUNTY OFFICIAL) (DEPUTY)

A-23

M-69