

USDA-FOREST SERVICE

Index
File No. B-21

CORNER RECORD (SEARCH)


(Ref. FSM 7151.4)

Tract or
Survey No. _____ Cor.
No. _____

T 6S. R. 30E. R.D. Okiah County Umatilla

Merid. Willamette N.F. Umatilla State Oregon

CORNER DIAGRAM

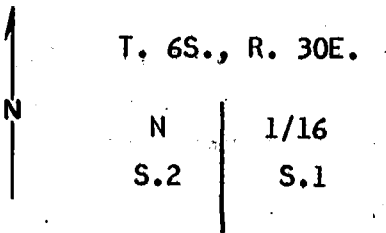

DESCRIBE CORNER MONUMENT FOUND

None

Set brass cap

DESCRIBE BEARING TREES OR OTHER OFFICIAL ACCESSORIES FOUND

None

PHOTO IDENTIFICATION DATA

Photo No. _____

Filed At. _____

Object Ident. _____

Ident. By _____

Signature

PLANE COORDINATE POSITION DATA

State _____ Zone _____

X _____

Y _____

Estab. By _____

Agency

DESCRIBE CORNER LOCATION RELATIVE TO NEAR-BY FEATURES, ALSO HOW TO REACH CORNER

From Gulliford Crossing sign on U. S. Forest Road 537N, go East 1.3 miles, then walk South 20.5 chns. to corner.

Signature
David H. Kline

Title _____ Division _____ Headquarters _____ Date _____

OPLS 733

7-77

7100-52-(3/68)

CORNER RECORD (PERPETUATION)

MONUMENT : DESCRIBE NEW MONUMENT SET, OR WORK DONE TO PRESERVE EXISTING MONUMENT

Set 2½" x 30" iron pipe with brass cap.
 Pipe is 16" in ground.
 Mound of stones to cap.
 Stamped:

T. 6S., R. 30E.
 N. 1/16
 S.2 S.1
 1977
 PLS 933

9

ACCESSORIES : DESCRIBE NEW BT'S WITNESS OBJECTS ETC. ESTABLISHED, OR WORK DONE TO PRESERVE EXISTING EVIDENCE

A 10" pine bears S. 87°54' W. 54.5 ft.
 A 10" pine bears N. 55°26' E. 27.7 ft.

Set steel fence post 4 ft. North of corner w/sign.
 Painted red band around BT trees w/sign.

10

Work Done By. T. Hamby Title Party Chief Date 6/23/77 State Registration No. _____
 or Agency _____

Certified Cor. Record Prepared? Yes No Filed At: _____ Date _____ 11

REMARKS

12

Index File No. T. R. M. Tract or Surv. No. Cor. 13