


CERTIFIED RECORD OF LAND CORNER MONUMENTATION

History of original corner establishment:

Unsurveyed - subdivided section

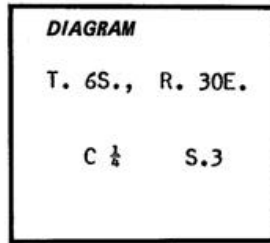

No record of subsequent remonumentation found in County Records.

Description of corner evidence found:


None.

Description of monument and accessories established to perpetuate the original location of this corner:

Set 2½" x 30" iron pipe 12" in ground with brass cap marked as shown:  
From which I scribed Bearing Trees.

A 9" pine bears N. 18° W. 43.6 ft. mkd. c ¼ S.3 BT.  
A 9" pine bears S. 34° W. 45.5 ft. mkd. c ¼ S.3 BT.

Nailed a brass washer mkd. PLS 933 to the BT blaze on both trees. Set a steel fence post 3 ft. West of corner. Raised mound of stone 3 ft. base within 3" of top of pipe. Used transit and steel tape, measuring to the center of BTs.

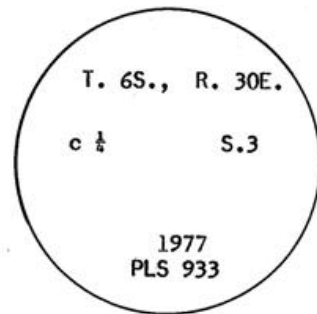

Office of.....County Surveyor..... County of.....Umatilla.....  
 State of.....Oregon..... I hereby certify that the within instrument was filed in this office  
 for record on the..... day of....., 19.....  
*David H. Krumbain* by.....  
 (COUNTY OFFICIAL) (DEPUTY)

C-15