


History of original corner establishment:

Unsurveyed - subdivided section

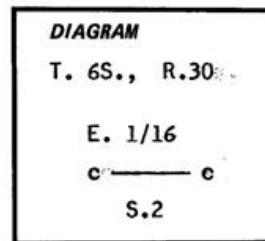

No record of subsequent remonumentation found in County Records.

Description of corner evidence found:

None.


Description of monument and accessories I established to perpetuate the original location of this corner:

Set 2 1/2" x 30" iron pipe 18" in ground with a brass cap marked as shown: From which I scribed Bearing Trees.

A 9" pine bears N. 26°00' W. 13.6 ft. mkd. CE 1/16 S.2 BT.

A 8" pine bears S. 23°47' E. 25.7 ft. mkd. CE 1/16 S.2 BT.

Nailed a brass washer mkd. PLS 933 on the BT blaze of both trees. Set steel fence post 3 ft. West of corner. Corner is 30 ft. South of E-W road. Raised mound stone 3 ft. base within 2" of top of pipe. Used transit and steel tape, measuring to the center of BTs.

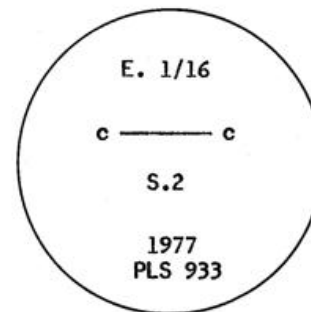

Office of.....County Surveyor..... County of.....Umatilla.....
 State of.....Oregon....., I hereby certify that the within instrument was filed in this office
 for record on the..... day of....., 19.....
David H. Krumbein by.....
 (COUNTY OFFICIAL) (DEPUTY)

C-20