


CERTIFIED RECORD OF LAND CORNER MONUMENTATION

M-64

History of original corner establishment: Corner established in 1884
by Frank W. Campbell, under contract No. 380
39.70 set a pine post for 1/4 sec. cor., from which

A pine 18 in. diam. brs. N. 34° W. 35 lks dist.
A pine 18 in. diam. brs. S. 58° W. 33 lks dist.

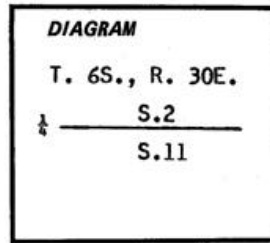

No record of subsequent remonumentation found in County Records.

Description of corner evidence found:


None

Description of monument and accessories established to perpetuate the original location of this corner:

Set 2 1/2" x 30" iron pipe 20" in ground with brass cap marked as shown. From which I scribed New Bearing Trees:

A 18" pine bears N. 70°00' E. 61.3 ft. mkd. 1/4 S.2 BT.
A 14" pine bears S. 31°58' E. 38.0 ft. mkd. 1/4 S.11 BT.

I nailed a brass washer to the BT blaze of both trees. Set fence post 2 ft. North of corner. Corner is 100 ft. North of road. Raised stone mound 3 ft. base within 3" of top of pipe. Used transit and steel tape, measuring to the center of BTs.

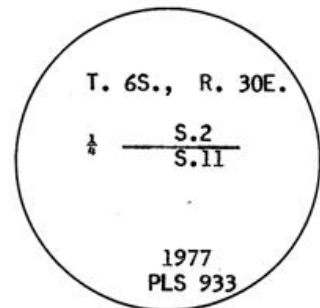

Office of.....County Surveyor..... County of.....Umatilla.....
State of.....Oregon....., I hereby certify that the within instrument was filed in this office
for record on the..... day of....., 19.....
..... by
(COUNTY OFFICIAL) (DEPUTY)

E-19

m-64