

USDA-FOREST SERVICE

Index
File No. E-5

CORNER RECORD (SEARCH)

(Ref. FSM 7151.4)

Tract or
Survey No. _____ No. Sec. Cor. _____


T 6S R. 30E

R.D. Ukiah County Umatilla

Merid. Willamette

N.F. Umatilla State Oregon

CORNER DIAGRAM.

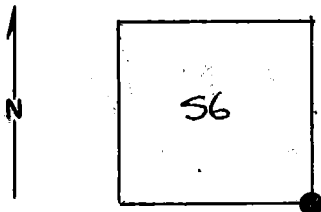

DESCRIBE CORNER MONUMENT FOUND

None

DESCRIBE BEARING TREES OR OTHER OFFICIAL ACCESSORIES FOUND

None

PHOTO IDENTIFICATION DATA

Photo No. _____

Filed At. _____

Object Ident. _____

Ident. By _____

Signature

PLANE COORDINATE POSITION DATA

State _____ Zone _____

X _____

Y _____

Estab. By _____

Agency

Signature

DESCRIBE CORNER LOCATION RELATIVE TO NEAR-BY FEATURES, ALSO HOW TO REACH CORNER

Corner is approximately 1000' East of U.S.F.S. 5327 Road.
Location tag on East side of Road.

PLS

346

9/79

Title

Division

Headquarters

Date

7100-52 (3/68)

CORNER RECORD (PERPETUATION)

MONUMENT: DESCRIBE NEW MONUMENT SET, OR WORK DONE TO PRESERVE EXISTING MONUMENT

Set 32" X 2" flanged iron pipe with brass cap marked:

T6S R30E
S6 | S5
S7 | S8
1979
PLS 346

ACCESSORIES : DESCRIBE NEW BT'S WITNESS OBJECTS ETC. ESTABLISHED, OR WORK DONE TO PRESERVE EXISTING EVIDENCE

Ponderosa Pine, 7" Dia., BRS. N46°E., 18.5 Ft. Distance.
Douglas Fir, 10" Dia., BRS. S37°E., 26.7 Ft. Distance.
Douglas Fir, 14" Dia., BRS. S17°W., 33.7 Ft. Distance.
Douglas Fir, 18" Dia., BRS. N48°W., 48.4 Ft. Distance.
6' Iron Fence Post with "Survey Monument" sign within 5' of Corner.

Work Done By Wayne O. Harris Title PLS Date 9/79 State Registration No. 346
or Agency

Certified Cor. Record Prepared ? YES ~~NO~~ Filed At: Umatilla Co., Surveyor Office Date

REMARKS

Index File No. E-5 T. 6S R. 30E W. M. Tract or Surv. No. Cor. 615
718

USDA-FOREST SERVICE

Index

File No. E-5

CORNER RECORD (SEARCH)

(Ref. FSM 7151.4)

Tract or Survey No. _____ Cor. No. _____


T 6S R. 30E

R.D. Ukiah County _____

Merid. Willamette

N.F. Umatilla State Oregon

CORNER DIAGRAM

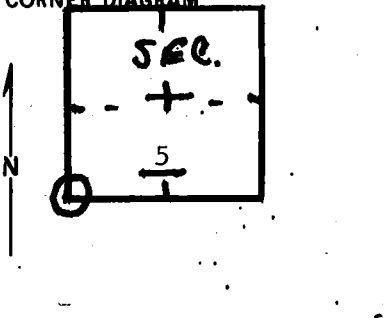

DESCRIBE CORNER MONUMENT FOUND

NONE

DESCRIBE BEARING TREES OR OTHER OFFICIAL ACCESSORIES FOUND

NONE.

Heppner Lmbr. Co. location poster on 8" Douglas Fir indicates that this tree is the corner. There are the remains of 4 down and very rotten pine trees, all in the proper locations for the original B.T.'s, but could find no other scribing. Most have been chopped on. There is a Heppner Lmbr. Co. location poster on the road Approx. 800' West.

PHOTO IDENTIFICATION DATA

Photo No. _____
 Filed At. _____
 Object Ident. _____
 Ident. By _____
 Signature _____

DESCRIBE CORNER LOCATION RELATIVE TO NEAR-BY FEATURES, ALSO HOW TO REACH CORNER

PLANE COORDINATE POSITION DATA

State _____ Zone _____
 X _____
 Y _____
 Estab. By _____
 Agency _____

Signature

Title

Division

Headquarters

Date

7100-52-(3/68)

T. HOLLAMON

ENG. TECH

5/10/78

CORNER RECORD (PERPETUATION)

 MONUMENT: DESCRIBE NEW MONUMENT SET, OR WORK DONE TO PRESERVE EXISTING MONUMENT

9

 ACCESSORIES : DESCRIBE NEW BT's WITNESS OBJECTS ETC. ESTABLISHED, OR WORK DONE TO PRESERVE EXISTING EVIDENCE

10

 Work Done By _____ Title _____ Date _____ State Registration No. or Agency _____

 Certified Cor. Record Prepared ? Yes No Filed At: _____ Date _____ 11

REMARKS

12

 Index File No. T. R. M. Tract or Surv. No. Cor. 13
