


CERTIFIED RECORD OF LAND CORNER MONUMENTATION

History of original corner establishment:

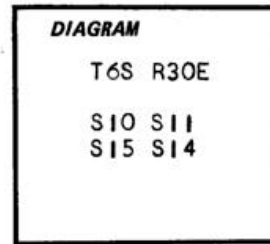

- A PINE POST
- 30" FIR S42E 6LKS.
- 40" PINE N44W 66 LKS.
- 10" PINE S50W 90 LKS.
- 40" PINE N11E 77 LKS.

Description of corner evidence found:

SMALL MOUND OF STONES


- 36" FIR S42E 4.0' SCRIBING VISIBLE
- 40" PINE SNAG N44W 43.6' SCRIBING VISIBLE
- 16" PINE S50W 59.4' SCRIBING VISIBLE
- 40" DOWN PINE SNAG N11E 50.8' SCRIBING NOT SEARCHED FOR.

Description of monument and accessories | established to perpetuate the original location of this corner:

SET A 2"x30" IRON PIPE WITH A BRASS-CAP MARKED:

T6S R30E
 S10 S11
 S15 S14
 1978
 PLS 346

- 12" PINE N52W 45.6' MARKED: T6S R30E S10 BT
- 10" FIR N51E 22.8' MARKED: T6S R30E S11 BT

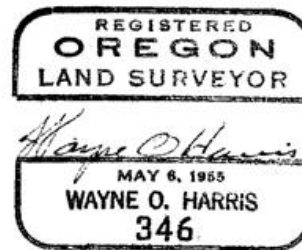

Office of.....COUNTY...SURVEYOR..... County of...**U.M.A.T.I.L.L.A.**.....
 State of.....**OREGON**....., I hereby certify that the within instrument was filed in this office
 for record on the..... day of....., 19.....
M.D. Harris..... by.....
 (COUNTY OFFICIAL) (DEPUTY)

RECEIVED SEP 11

Jul
1978