

USDA-FOREST SERVICE


Index
File No. J-17

CORNER RECORD (SEARCH)
(Ref. FSM 7151.4)

Tract or
Survey No. _____ No. _____

T 6S R. 30E R.D. UKIAH County UMATILLA
Merid. WILLAMETTE N.F. UMATILLA State OREGON

CORNER DIAGRAM

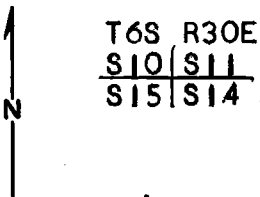

DESCRIBE CORNER MONUMENT FOUND

NONE

DESCRIBE BEARING TREES OR OTHER OFFICIAL ACCESSORIES FOUND

36" FIR S42E 4.0' SCRIBING VISIBLE
40" PINE SNAG N44W 43.6' SCRIBING VISIBLE
16" PINE S50W 59.4' SCRIBING VISIBLE
40" DOWN PINE SNAG N11E 50.8' SCRIBING NOT SEARCHED FOR

PHOTO IDENTIFICATION DATA

Photo No. _____
Filed At. _____
Object Ident. _____
Ident. By _____
Signature

DESCRIBE CORNER LOCATION RELATIVE TO NEAR-BY FEATURES, ALSO HOW TO REACH CORNER

THERE IS A LOCATION TAG APX. 150' SOUTH OF CORNER ON OLD ROAD.

PLANE COORDINATE POSITION DATA

State _____ Zone _____
X _____
Y _____
Estab. By _____
Agency

Title _____ Division _____ Headquarters _____ Date _____

J.H.O. Davis
Signature

CORNER RECORD (PERPETUATION)

GPO 902-678

MONUMENT: DESCRIBE NEW MONUMENT SET, OR WORK DONE TO PRESERVE EXISTING MONUMENT

SET A 2"x30" IRON PIPE WITH BRASS-CAP MARKED: T6S R30E
 S10 S11
 S15 S14
 1978
 PLS 346

ACCESSORIES : DESCRIBE NEW BT'S WITNESS OBJECTS ETC. ESTABLISHED, OR WORK DONE TO PRESERVE EXISTING EVIDENCE

12" PINE N52W 45.6' MARKED: T6S R30E S10 BT
 10" FIR N51E 22.8' MARKED: T6S R30E S11 BT

ALL TREES HAVE A RED PAINTED STRIPE, BEARING TREE TAGS, AND AN ATTENTION SIGN. THE NEW BT'S HAVE A BRASS WASHER STAMPED PLS 346 NAILED TO THE LOWER BLAZE. THERE IS A STEEL FENCE POST ON LINE NORTH AND EAST OF COR.

Work Done By W.O. HARRIS Title _____ Date 9-7-78 State Registration No. PLS 346
 or Agency _____

Certified Cor. Record Prepared? Yes No Filed At: _____ Date _____

REMARKS

Index File No. T. R. M. Tract or Surv. No. Cor.

12

13

USDA-FOREST SERVICE

Index File No. J-17


CORNER RECORD (SEARCH)
(Ref. FSM 7151.4)

Tract or Survey No. _____ No. J-17

T 6S R. 30E
Merid. Will.

R.D. Ukiah County Umatilla
N.F. Umatilla State Oregon

CORNER DIAGRAM

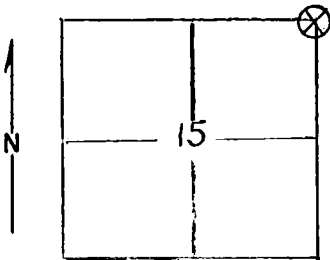

DESCRIBE CORNER MONUMENT FOUND

None

DESCRIBE BEARING TREES OR OTHER OFFICIAL ACCESSORIES FOUND

A 30" Douglas fir bearing S42°E 6 lks is in good vigor, attached bearing and attention signs and painted 6" red band and scars. No scribing visible. A 19" pine bearing S50°W 90 lks is in good condition. Fixed the same as fir, no scribing visible but has some faint scribing on it. Marked the same as other two trees. ~~No other trees could be found for sure. Put up two metal posts.~~

DESCRIBE CORNER LOCATION RELATIVE TO NEAR-BY FEATURES, ALSO HOW TO REACH CORNER

PHOTO IDENTIFICATION DATA

Photo No. _____
Filed At. _____
Object Ident. _____
Ident. By _____

Signature

PLANE COORDINATE POSITION DATA

State _____ Zone _____
X _____
Y _____
Estab. By _____

Agency

Signature
MLC

Title
For, Tech,

Division
USFS

Headquarters
Ukiah

Date
4/20/78

7100-52-(3. 68)