

Index
File No. N-25

CORNER RECORD (SEARCH)

(Ref. FSM 7151.4)

Tract or
Survey No. _____
Cor.
No. N-25

T 65 R. 29E

R.D. UKIAH


County MORROW

Merid. W.M.

N.F. UMATILLA

State OREGON

CORNER DIAGRAM

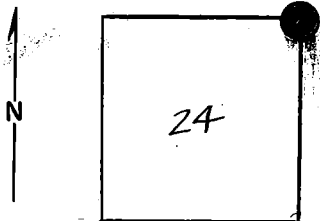

DESCRIBE CORNER MONUMENT FOUND

None

DESCRIBE BEARING TREES OR OTHER OFFICIAL ACCESSORIES FOUND

FD. SW BT - A DEAD AND DOWN PINE STUMP
WITH A DIM BT VISABLE.
NO EVIDENCE OF OTHER BTs

PHOTO IDENTIFICATION DATA

Photo No. _____
Filed At. _____
Object Ident. _____
Ident. By _____
Signature

DESCRIBE CORNER LOCATION RELATIVE TO NEAR-BY FEATURES, ALSO HOW TO REACH CORNER

PLANE COORDINATE POSITION DATA

State _____ Zone _____
X _____
Y _____
Estab. By _____
Agency

Signature

D J Sniffel

Title

RS649

Division

Headquarters

Date

10/75 7100-52 (3/68)

4

5

CORNER RECORD (PERPETUATION)

MONUMENT: DESCRIBE NEW MONUMENT SET, OR WORK DONE TO PRESERVE EXISTING MONUMENT

SET 2 1/2" x 30" IRON PIPE WITH BRASS CAP.

9

ACCESSORIES: DESCRIBE NEW 'BT'S WITNESS OBJECTS ETC. ESTABLISHED, OR WORK DONE TO PRESERVE EXISTING EVIDENCE

NEW BT'S

A 14" FIR, N44E, 63.9 FT

A 12" PINE, S16E, 14.9 "

A 14" FIR, S27W, 26.7 "

A 10" PINE, N45W, 14.0 "

10

Work Done By D. I. GRIFFITH Title SURVEYOR Date _____ State Registration No. ORE. PLS 644
or Agency _____

Certified Cor. Record Prepared? Yes No _____ Filed At: MORROW CO. CT. HO. Date 12/75

11

REMARKS

SEE MAP OF SURVEY DATED DEC. 1975

12

Index File No. N-25 T. 6S R. 29E WM.

Tract or Surv. No. _____

Cor. 0-25 13


LAND CORNER RECORD

(Rectangular)

C.R.

1. T 6S R 30E No. N-1 Cor. Sec. Mer. W State Oregon N. F. Umatilla Dist. Ukiah 7

2. Corner Status

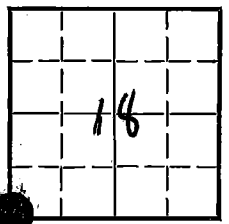

3. Original Description _____ Vol. _____ Page _____ Where Recorded _____

4. Description of Corners:
Ref: T. 6 S., R. 29 E., N-25
Brass Cap; see Monumentation File.

5. Investigation Notes:

7. Photo Identification

Photo No. _____
Ident. By: _____

8. Plane Coordinate Position Data

State _____ Zone _____
X _____
Y _____
Estab. By _____
Field Book No. _____
Where Filed _____

9. Evaluation

Authentic _____
Needs Verif. _____ Monument _____
Re-estab. _____ Survey _____
Land Status _____

6. Signed _____ Title _____ Date _____

PERPETUATION RECORD

10. Monument:

11. Accessories

Field Book _____ Page _____

12. Set By _____ Title _____
License _____ Agency _____ Date _____

13. Recorded By: _____ Volume _____ Page _____
(Agency)

(Date) (City) (County) (State)

14. Remarks:

N-1