


Index
File No. A-5
T 6S R. 32E
Merid. WILLAMETTE

CORNER RECORD (SEARCH)
(Ref. FSM 7.151.4)
R.D. UKIAH County UMATILLA
N.F. UMATILLA State OREGON

Tract or Survey No. _____
Cor. No. _____

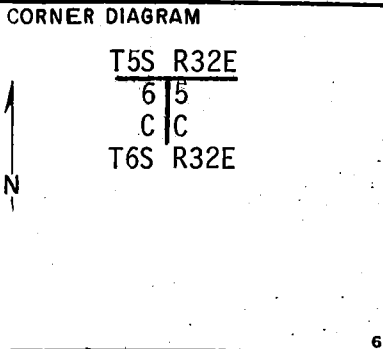

DESCRIBE CORNER MONUMENT FOUND
Found an iron pipe, 2½ ins. diam., firmly set, with brass cap attached, marked

U.S. Dept. of Interior
Bureau of Land Management
T5S R32E
S31
S6 | S5
T6S | R32E 2

DESCRIBE BEARING TREES OR OTHER OFFICIAL ACCESSORIES FOUND
The 1968 BLM bearing trees.
An 18" Ponderosa Pine; alive with scribing visible on a partially healed blaze, bears N 34°E 171.0 ft. (Record 166.0 ft.)
And a 12" Ponderosa Pine, alive and well-healed, bears N 81°W 48.1 ft. (Record 55.8 ft.)

C C
1968

PHOTO IDENTIFICATION DATA
Photo No. 280-293
Filed At. UMATILLA Nat. For.
Object Ident. SUB. STA.
Ident. By D. J. Smith
Signature

DESCRIBE CORNER LOCATION RELATIVE TO NEAR-BY FEATURES, ALSO HOW TO REACH CORNER 3

PLANE COORDINATE POSITION DATA
State _____ Zone _____
X _____
Y _____
Estab. By _____
Agency

Signature D. J. Smith 8

Title LS 1099 Division _____ Headquarters _____ Date 9-18-84 4
FS-7100-52 (3/68)

CORNER RECORD (PERPETUATION)

MONUMENT: DESCRIBE NEW MONUMENT SET, OR WORK DONE TO PRESERVE EXISTING MONUMENT

None

9

ACCESSORIES: DESCRIBE NEW SETS, WITNESS OBJECTS ETC. ESTABLISHED, OR WORK DONE TO PRESERVE EXISTING EVIDENCE

None

10

Work Done By Gary Langlitz Title LS 1099 Date 8-84 State Registration No. _____
or Agency _____
Certified Cor. Record Prepared Yes No Filed At: UMATILLA Co. SURVEYOR Date 9-84 11

REMARKS

Magnetic Compass (20° East Declination)
Steel Tape

12

Index File No. A-5 T. 6S R. 32E M. WILLAMETTE Tract or Surv. No. _____ Cor. _____ 13

CORNER RECORD (SEARCH)

Index
File No. A-5

(Ref. FSM 7151.4)

Tract or Survey No. 5-6 Cor. No. A-5


T 6S R. 32E

R.D. Ukiah County Umatilla


Merid. Willamette

N.F. Umatilla State Oregon

CORNER DIAGRAM

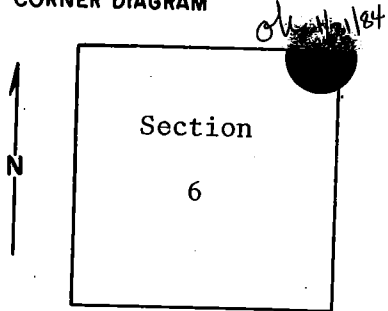

DESCRIBE CORNER MONUMENT FOUND
Material: Iron pipe with brass cap.
Size: 2" pipe, 3/4" cap.
6" above ground; good condition.
Set in small stone mound (20" diameter, 6" deep). (cont. in block 12)

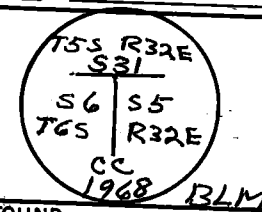

DESCRIBE BEARING TREES OR OTHER OFFICIAL ACCESSORIES FOUND
A 12-inch p.pine with B.T. tag bears N81°W, approximately 55 feet. Scribing pitched over and illegible. Apparently set in 1968.
A very limby 16-inch p.pine with B.T. tag bears N34°E, approximately 160 feet. Scribing appears to be XR, B.T.
I assume both trees are cross-reference B.T.'s since they grow in T5S and the corner is common to S5 and S6 of T6S only. There are no available trees on the T6S side (cont. in block 12);

DESCRIBE CORNER LOCATION RELATIVE TO NEAR-BY FEATURES, ALSO HOW TO REACH CORNER
Corner occurs about 100 feet west of small drainage. The corner to Section 36, T5S, R31E, and Section 31, T5S, R32E, is about 300 feet west on the same fence line.
From forest boundary on road S-522, proceed east on road S-522 for about 1.1 miles. (To section line board and location poster on south side of road.) Corner is on fence line about 500 feet north.

PHOTO IDENTIFICATION DATA

Photo No. _____
Filed At. _____
Object Ident. _____
Ident. By _____
Signature

PLANE COORDINATE POSITION DATA

State _____ Zone _____
X _____
Y _____
Estab. By _____
Agency

Signature T. Hollamon Title Engineering Technician Division Headquarters Date March 21, 1974
S. O. 7100-52-(3/68)

CORNER RECORD (PERPETUATION)

MONUMENT : DESCRIBE NEW MONUMENT SET, OR WORK DONE TO PRESERVE EXISTING MONUMENT

9

ACCESSORIES : DESCRIBE NEW BT'S WITNESS OBJECTS ETC. ESTABLISHED, OR WORK DONE TO PRESERVE EXISTING EVIDENCE

10

Work Done By _____ Title _____ Date _____ State Registration No. _____
or Agency _____

Certified Cor. Record Prepared ? Yes No Filed At: _____ Date _____

11

(Block #2, cont.) Monument is 4 feet ^{REMARKS} north of fence.
(Block #3, cont.) of the line.
There is a mound of stone approximately 10 feet SW of corner (on south side of fence).
There is an attention (warning) poster and a location poster on the fence posts nearby.

12

Index File No. T. R. M. Tract or Surv. No. Cor.

13