


Index
File No. V-5
T 6S R. 33E
Merid. WILLAMETTE

CORNER RECORD (SEARCH)

(Ref. FSM 7151.4)

Tract or Survey No. _____ Cor. No. _____
R.D. N.F. JOHN DAY County UMATILLA
N.F. UMATILLA State OREGON

CORNER DIAGRAM

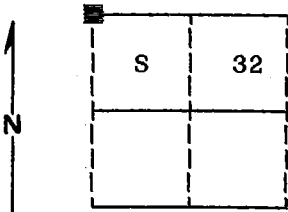

DESCRIBE CORNER MONUMENT FOUND

Found standard BLM brass cap monument marked as shown;

T6S R33E	
S 30	S 29
S 31	S 32
1977	

DESCRIBE BEARING TREES OR OTHER OFFICIAL ACCESSORIES FOUND

Found 12" Douglas Fir N33°E, 23 lks, live and vigorous with scribes visible. Found a 11" Douglas Fir S34°E, 29½ lks dying with scribes visible. Found a 18" Ponderosa Pine snag S44°W, 105 lks with scribes visible. Found a 13" Douglas Fir S51°W 46 lks, sickly with scribes visible. Found a 11" Douglas Fir N65°W, 21 lks, sickly with scribes visible. Found a Pine stump S33°E, 38 lks, scribes visible.

PHOTO IDENTIFICATION DATA

Photo No. 280-228
Filed At. Ranger Office
Object Ident. Corner
Ident. By D.I. Griffith
Signature

DESCRIBE CORNER LOCATION RELATIVE TO NEAR-BY FEATURES, ALSO HOW TO REACH CORNER

Corner falls on timbered West hillside approximately 300 feet West of a road.

PLANE COORDINATE POSITION DATA

State _____ Zone _____
X _____
Y _____
Estab. By _____

Signature
Agent

Signature _____ Title _____ Division _____ Headquarters _____

Date 8-1-87 FS-7100-52 (3/68)

CORNER RECORD (PERPETUATION)

MONUMENT: DESCRIBE NEW MONUMENT SET, OR WORK DONE TO PRESERVE EXISTING MONUMENT

Raised mound of stone around the existing monument,
3 ft. base to top of cap.

9

ACCESSORIES : DESCRIBE NEW BT'S WITNESS OBJECTS ETC. ESTABLISHED, OR WORK DONE TO PRESERVE EXISTING EVIDENCE

New BTs:

A Ponderosa Pine 11" diam. bears S58°E, 83.91 feet marked T6S R33E S32 BT
A Ponderosa Pine 11" diam. bears S72°W, 58.10 feet marked T6S R33E S31 BT
A Ponderosa Pine 14" diam. bears N15°W, 48.94 feet marked T6S R33E S30 BT

Painted a 6 inch red band around all bearing trees and attached 54-3 and 54-4 signs.
Set a steel fencepost approximately 5 feet North with 54-4 sign attached.

10

Work Done By D.I. Griffith Title Surveyor Date 7-14-87 State Registration No. OPLS 644
Or Agency

Certified Cor. Record Prepared ? Yes No Filed At: Umatilla Co. Survey Office Date 8-86

11

REMARKS

12

Index File No. V-5 T. 65 R. 33E WM. Tract or Surv. No. Cor.

13

u-5

Index File No. V-5

CORNER RECORD (SEARCH)


Tract or Survey No. _____

LL 13
Cor. No. V-5

T 6S R. 33E
Merid. Willamette

R.D. Ukiah County Umatilla
N.F. Umatilla State OREGON

CORNER DIAGRAM

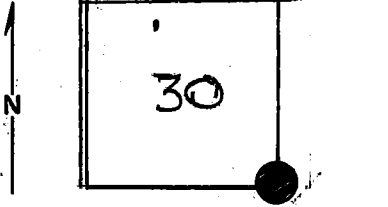

DESCRIBE CORNER MONUMENT FOUND

found for stone which may be remnants of original corner.
Brass Cap! See 11041 File.

DESCRIBE BEARING TREES OR OTHER OFFICIAL ACCESSORIES FOUND

PINE BT (rotted stump), S33°E from approx. corner, 38' W
P. PINE BT (SNAG), S44°S of approx. corner, 105' W, 24" DBH.
↑ W?

PHOTO IDENTIFICATION DATA

Photo No. EQO 7-158 (9-1-66)
Filed At. _____
Object Ident. Red Cross Pine
Ident. By M. Benson
Signature

DESCRIBE CORNER LOCATION RELATIVE TO NEAR-BY FEATURES, ALSO HOW TO REACH CORNER

found corner by following Forest Service Road Number 5612. Two road sign boards are 1156 ft. south and 336 ft. east of the corner.

PLANE COORDINATE POSITION DATA

State _____ Zone _____
X _____
Y _____
Estab. By _____
Agency

Signature: Kentagon

Title E.A. Division USFS Headquarters Umatilla N.F. SO.

Date 8/1/69

CORNER RECORD (PERPETUATION)

MONUMENT: DESCRIBE NEW MONUMENT SET, OR WORK DONE TO PRESERVE EXISTING MONUMENT

Flagged and painted red the stone and stone.

ACCESSORIES: DESCRIBE NEW BT'S WITNESS OBJECTS ETC. ESTABLISHED, OR WORK DONE TO PRESERVE EXISTING EVIDENCE

Flagged, painted red the BT's.
Posted "BT" and "attention" signs.

Work Done By. MARVIN BENSON Title ENG. Aide Date 7/23/69 State Registration No. USFS
or Agency

Certified Cor. Record Prepared? Yes No Filed At: _____ Date _____

REMARKS
NW & NE BT's (N82°W & N29°E) not positively identified.
Used 2"/mi. map and aerial photo numbers EQO-7-158(9-1-61)

Index File No. V-5 T. 6S R. 33E M. Will. Tract or Surv. No. _____ Cor. V-5