

Index  
File No.

**CORNER RECORD (SEARCH)**  
(Ref. FSM 5151.4)

Tract or  
Survey No.

**Tower Unit**


Cor.  
No. **AP-185**

T. 6 S. R. 34 E.  
Merid. Willamette

R.D. North Fork John Day  
N.F. Umatilla

County Umatilla  
State Oregon

**CORNER DIAGRAM**

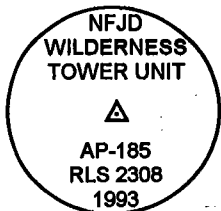

**DESCRIBE CORNER MONUMENT FOUND**

Found a 5/8" rebar with 3 1/4" aluminum cap, projecting 2" out of the ground.

**DESCRIBE BEARING TREES OR OTHER OFFICIAL ACCESSORIES FOUND**

13" Subalpine Fir Snag, S. 2 E., 10.9 feet, with scribing visible on double blaze.  
7" Subalpine Fir, N. 72 W., 13.2 feet, with scribing visible on double blaze.

**PHOTO IDENTIFICATION DATA**

Photo No.  
Filed At.  
Object Ident.  
Ident. By

Signature

**DESCRIBE CORNER LOCATION RELATIVE TO NEAR-BY FEATURES, ALSO HOW TO REACH CORNER**

From the jct. Of roads 5226 and 5226-200 travel northerly on 5226 approx. 0.56 miles. The corner is located westerly approx. 200 feet from the road.

**PLANE COORDINATE POSITION DATA**

State: Zone:  
X:  
Y:  
Datum:

Signature

D. Schlaich

Title

Land Surveyor

Division

Headquarters

S.O.

Date

10/23/1997

FS-7100-52 (3/97)

CORNER RECORD (PERPETUATION)

MONUMENT: DESCRIBE NEW MONUMENT SET, OR WORK DONE TO PRESERVE EXISTING MONUMENT

ACCESSORIES: DESCRIBE NEW BT'S WITNESS OBJECTS ETC. ESTABLISHED, OR WORK DONE TO PRESERVE EXISTING EVIDENCE

13" Subalpine Fir, S. 84 ½ E., 24.6 feet, scribed "WB\185" "BT" on double blaze.

9" Subalpine Fir, N. 15 W., 26.6 feet scribed "WB/185" "BT" on double blaze.

Work Done By D. Schlaich Title Land Surveyor Date 10/23/1997 State Registration No. \_\_\_\_\_  
or Agency \_\_\_\_\_  
Certified Corner Record Prepared? Yes  No  Filed At: \_\_\_\_\_ Date \_\_\_\_\_

REMARKS

Index

File No.

T. 6 S. R. 34 E.

Merid. WILLAMETTE

**CORNER RECORD (SEARCH)**

(Ref. FSM 7151.4)

R.D. NFJD

N.F. UMATILLA

County UMATILLA

State OREGON


Tract or

Survey No. Tower Unit

Cor.

No. AP-185

**CORNER DIAGRAM**

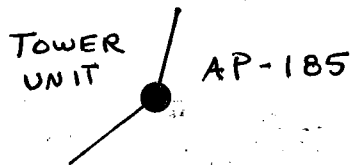

**DESCRIBE CORNER MONUMENT FOUND**

NONE

**DESCRIBE BEARING TREES OR OTHER OFFICIAL ACCESSORIES FOUND**

NONE

**PHOTO IDENTIFICATION DATA**

Photo No.:

Filed At:

Object Ident.:

Ident. By:

*Signature*

**DESCRIBE CORNER RELATIVE TO NEAR-BY FEATURES, ALSO HOW TO REACH CORNER**

From the jct. of FS rds. 5226 and 5226-200 travel northerly on 5226 approx. 0.56 miles. The corner is located westerly approx. 200 feet from the road.

**PLANE COORDINATE POSITION**

State: Oregon Zone: North

X: 2,499,919.25'

Y: 512,823.73'

Datum: NAD1927

*Signature*

D. Schlaich

Title

Land Surveyor

Division

Headquarters

S.O.

Date

09-1993

FS-7100-52 (3/68)

CORNER RECORD (PERPETUATION)

MONUMENT: DESCRIBE NEW MONUMENT SET, OR WORK DONE TO PRESERVE EXISTING MONUMENT

5/8" by 36" rebar, with a 3 1/4" aluminum cap, marked "NFJD WILDERNESS TOWER UNIT AP-185 RLS2308 1993".

ACCESSORIES : DESCRIBE NEW BT's WITNESS OBJECTS ETC. ESTABLISHED, OR WORK DONE TO PRESERVE EXISTING EVIDENCE

13" Alpine Fir, S. 2° E., 11.2 ft., mkd. "WB/185""BT" on double blaze.

7" Alpine Fir, N. 72° W., 12.8 ft., mkd. "WB/185"BT" on double blaze.

Work Done By D. Schlaich

Title Land Surveyor

Date 09-1993

State Registration No.  
or Agency

Certified Cor. Record Prepared ? NO

Filed At:

Date

REMARKS

Index File No.

T.

6 S.

R.

34 E.

M.

W.M.

Tract or Survey No.

Cor.

AP-185