

Index

File No.

T. 6 S. R. 34 E.

Merid. WILLAMETTE

CORNER RECORD (SEARCH)

(Ref. FSM 7151.4)


Tract or
Survey No.

Cor.
No. AP-19

R.D. NFJD
N.F. UMATILLA

County UMATILLA
State OREGON

CORNER DIAGRAM

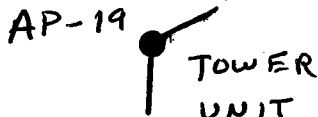

DESCRIBE CORNER MONUMENT FOUND
NONE

DESCRIBE BEARING TREES OR OTHER OFFICIAL ACCESSORIES FOUND
NONE

PHOTO IDENTIFICATION DATA

Photo No.:

Filed At.:

Object Ident.:

Ident. By:

Signature

PLANE COORDINATE POSITION DATA

State: Oregon Zone: North

X: 2,482,222.32'

Y: 511,530.02'

Datum: NAD1927

DESCRIBE CORNER RELATIVE TO NEAR-BY FEATURES, ALSO HOW TO REACH CORNER

The corner is on a high point on the ridge between North Fork Cable Creek and Winom Creek

Signature

D. Schlaich

Title

Land Surveyor

Division

Headquarters

S.O.

Date

08-1993

FS-7100-52 (3/68)

CORNER RECORD (PERPETUATION)

MONUMENT: DESCRIBE NEW MONUMENT SET, OR WORK DONE TO PRESERVE EXISTING MONUMENT

5/8" by 3/8" rebar with a 3 1/4" aluminum cap, flush with the ground, marked "NFJD WILDERNESS TOWER UNIT AP-19 RLS2308 1993"

ACCESSORIES : DESCRIBE NEW BT's WITNESS OBJECTS ETC. ESTABLISHED, OR WORK DONE TO PRESERVE EXISTING EVIDENCE

8" Western Larch, S. 63° E., 18.7 ft., mkd. "WB/19""BT" on double blaze.

8" Lodgepole Pine, N. 9° W., 8.8 ft., mkd. "WB/19""BT" on double blaze.

Work Done By **D. Schlaich**

Title Land Surveyor

Date 08-1993

State Registration No.
or Agency

Certified Cor. Record Prepared ? **NO**

Filed At:

Date

REMARKS

Index File No.

T.

6 S.

R.

34 E.

M.

W.M.

Tract or Survey No.

Cor.

AP-19