

Index
File No.

CORNER RECORD (SEARCH)

(Ref. FSM 5151.4)

Tract or
Survey No.

Tower Unit

Cor.
No. **AP-667**

T. 6 S. R. 34 E.
Merid. Willamette

R.D. North Fork John Day
N.F. Umatilla

County Umatilla
State Oregon

CORNER DIAGRAM



DESCRIBE CORNER MONUMENT FOUND

Found a 5/8" rebar with a 3 1/4" aluminum cap, projecting 6" out of the ground.

DESCRIBE BEARING TREES OR OTHER OFFICIAL ACCESSORIES FOUND

10" Lodgepole Pine Snag, N. 15 1/2 E., 8.5 feet, with burnt out double blaze.
7" Lodgepole Pine Snag, S. 30 1/4 E., 9.5 feet, with burnt out double blaze.

PHOTO IDENTIFICATION DATA

Photo No.
Filed At.
Object Ident.
Ident. By

Signature

DESCRIBE CORNER LOCATION RELATIVE TO NEAR-BY FEATURES, ALSO HOW TO REACH CORNER

The corner is located on the ridge between North Fork Cable creek and Winom creek.

PLANE COORDINATE POSITION DATA

State: Zone:

X:

Y:

Datum:

Signature

D. Schlaich

Title

Land Surveyor

Division

Headquarters

S.O.

Date

10/31/1997

FS-7100-52 (3/97)

CORNER RECORD (PERPETUATION)

MONUMENT: DESCRIBE NEW MONUMENT SET, OR WORK DONE TO PRESERVE EXISTING MONUMENT

ACCESSORIES: DESCRIBE NEW BT'S WITNESS OBJECTS ETC. ESTABLISHED, OR WORK DONE TO PRESERVE EXISTING EVIDENCE

RM, 5/8" X 24" rebar with yellow plastic cap stamped "UMATILLA N.F." set 22" in the ground, N. 67 3/4 E., 19.35 feet.
RM, 5/8" X 24" rebar with red plastic cap stamped "UMATILLA N.F." set 15" in the ground, S. 3 E., 20.2 feet.

Work Done By D. Schlaich Title Land Surveyor Date 10/31/1997 State Registration No. or Agency _____
Certified Corner Record Prepared? Yes No Filed At: _____ Date _____

REMARKS

Index File No.

T.

R.

M. Willamette

Tract or Survey No.

Tower Unit

Cor. AP-667

Index
File No.

T. 6 S. R. 34 E.
Merid. WILLAMETTE

CORNER DIAGRAM

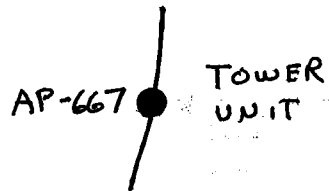


PHOTO IDENTIFICATION DATA

Photo No.:
Filed At.:
Object Ident.:
Ident. By: _____
Signature

PLANE COORDINATE POSITION DATA

State: Oregon Zone: North
X: 2,479,780.58'
Y: 502,797.28'
Datum: NAD1927

CORNER RECORD (SEARCH)
(Ref. FSM 7151.4)

R.D. NFJD County UMATILLA
N.F. UMATILLA State OREGON

Tract or
Survey No. Tower Unit

Cor.
No. AP-667

DESCRIBE CORNER MONUMENT FOUND

NONE

DESCRIBE BEARING TREES OR OTHER OFFICIAL ACCESSORIES FOUND

NONE

DESCRIBE CORNER RELATIVE TO NEAR-BY FEATURES, ALSO HOW TO REACH CORNER

The corner is located on the ridge between North Fork Cable creek and Winom creek.

Signature

D. Schlaich

Title

Land Surveyor

Division

Headquarters

S.O.

Date

07-1993

FS-7100-52 (3/68)

CORNER RECORD (PERPETUATION)

MONUMENT: DESCRIBE NEW MONUMENT SET, OR WORK DONE TO PRESERVE EXISTING MONUMENT

5/8" by 3/6" rebar, with a 3 1/4" aluminum cap, 33" in the ground, marked "NFJD WILDERNESS TOWER UNIT AP-667 RLS2308 1993".

ACCESSORIES : DESCRIBE NEW BT's WITNESS OBJECTS ETC. ESTABLISHED, OR WORK DONE TO PRESERVE EXISTING EVIDENCE

10" Lodgepole Pine, N. 16° E., 8.5 ft., mkd. "WB/667""BT" on double blaze.

8" Lodgepole Pine, S. 29° E., 9.5 ft., mkd. "WB/667""BT" on double blaze.

Both BT's have a 3/4" brass washer stamped "RLS 2308" nailed next to "BT" scribing on lower blaze.

Work Done By **D. Schlaich**

Title Land Surveyor

Date 07-1993

State Registration No.
or Agency

Certified Cor. Record Prepared? **NO**

Filed At:

Date

REMARKS

Index File No.

T.

6 S.

R.

34 E.

M.

W.M.

Tract or Survey No.

Tower Unit

Cor.

AP-667