

USDA-FOREST SERVICE  
Index  
File No.

**CORNER RECORD (SEARCH)**  
(Ref. FSM 5151.4)


Tract or  
Survey No. Tower Unit

Cor.  
No. **AP-475**

T. 6 S. R. 34 E.  
Merid. Willamette

R.D. North Fork John Day County Umatilla  
N.F. Umatilla State Oregon

**CORNER DIAGRAM**

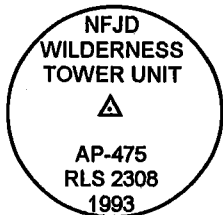

**DESCRIBE CORNER MONUMENT FOUND**

Found a 3 1/4" aluminum cap, set flush with the ground.

**DESCRIBE BEARING TREES OR OTHER OFFICIAL ACCESSORIES FOUND**

9" Lodgepole Pine Snag, N. 62 E., 25.5 feet, with burnt out double blaze.  
8" Western Larch Snag, S. 23 E., 14.0 feet, with burnt out double blaze.

**PHOTO IDENTIFICATION DATA**

Photo No.  
Filed At.  
Object Ident.  
Ident. By

Signature

**DESCRIBE CORNER LOCATION RELATIVE TO NEAR-BY FEATURES, ALSO HOW TO REACH CORNER**

From the jct. Of road 52 and trail 3156 (Big Creek) hike up the trail approx. 1.6 miles to the corner which is located 100 feet northwest of the trail.

**PLANE COORDINATE POSITION DATA**

State: Zone:

X:

Y:

Datum:

Signature

D. Schlaich

Title

Land Surveyor

Division

Headquarters

S.O.

Date

10/23/1997

FS-7100-52 (3/97)

CORNER RECORD (PERPETUATION)

MONUMENT: DESCRIBE NEW MONUMENT SET, OR WORK DONE TO PRESERVE EXISTING MONUMENT

ACCESSORIES: DESCRIBE NEW BT'S WITNESS OBJECTS ETC. ESTABLISHED, OR WORK DONE TO PRESERVE EXISTING EVIDENCE

6" Englemann Spruce, S. 70 E., 143.4 feet, scribed "WB/475" "BT" on double blaze.

RM, 5/8" X 24" rebar, with red plastic cap stamped "UMATILLA N.F.", set 23" in the ground, S. 55 1/2 W., 17.6 feet.

Work Done By D. Schlaich

Title Land Surveyor

Date 10/23/1997

State Registration No.  
or Agency

Certified Corner Record Prepared ?

Yes

No

Filed At:

Date

REMARKS

USDA-FOREST SERVICE

Index

File No.

T. 6 S.

R. 34 E.

Merid. WILLAMETTE

**CORNER RECORD (SEARCH)**

(Ref. FSM 7151.4)

R.D. NORTH FORK JOHN DAY

County UMATILLA

N.F. UMATILLA

State OREGON


Tract or

Survey No. TOWER UNIT

Cor.

No. AP-475

**CORNER DIAGRAM**

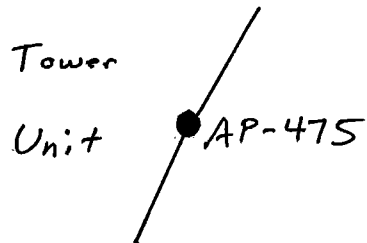

**DESCRIBE CORNER MONUMENT FOUND**

NONE

**DESCRIBE BEARING TREES OR OTHER OFFICIAL ACCESSORIES FOUND**

NONE

**PHOTO IDENTIFICATION DATA**

Photo No.:

Filed At.:

Object Ident.:

Ident. By:

*Signature*

**DESCRIBE CORNER RELATIVE TO NEAR-BY FEATURES, ALSO HOW TO REACH CORNER**

From the junction of road 52 and trail 3156 (Big creek) hike up the trail approx 1.6 miles to the corner which is located northwest of the trail 100 feet.

**PLANE COORDINATE POSITION DATA**

State: Oregon Zone: North

X: 2,494,766.77'

Y: 498,316.15'

Datum: NAD1927

Signature

D. Schlaich

Title

Land Surveyor

Division

Headquarters

S.O.

Date

07/1993

FS-7100-52 (3/68)

**CORNER RECORD (PERPETUATION)**

**MONUMENT: DESCRIBE NEW MONUMENT SET, OR WORK DONE TO PRESERVE EXISTING MONUMENT**

Set at a point 100 feet northwesterly of and perpendicular to the centerline of trail 3156, a 5/8" by 36" rebar, with a 3 1/4" aluminum cap, flush with the ground, mkd. "NFJD WILDERNESS TOWER UNIT AP-475 RLS 2308 1993"

**ACCESSORIES : DESCRIBE NEW BT's WITNESS OBJECTS ETC. ESTABLISHED, OR WORK DONE TO PRESERVE EXISTING EVIDENCE**

10" Lodgepole Pine, N 63° E, 25.5 ft., mkd. "WB/475" "BT".

9" Western Larch, N 23° E, 14.0 ft., mkd. "WB/475" "BT".

BT's are double blazed and have a 3/4" brass washer mkd. "RLS 2308" nailed to the lower blaze by the "BT" scribing.

Work Done By **D. Schlaich**

Title **Land Surveyor**

Date **07/1993**

State Registration No.  
or Agency

Certified Cor. Record Prepared ? **NO**

Filed At:

Date

**REMARKS**

Index File No.

T.

**6 S.**

R.

**34 E.**

M.

**W.M.**

Tract or Survey No.

**TOWER UNIT**

Cor.

**AP-475**