

CORNER RECORD (SEARCH)

(Ref. FSM 5151.4)

Tract or
Survey No.

Tower Unit

Cor.
No. **AP-599**

T. 6 S. R. 34 E.

Merid. Willamette


R.D. North Fork John Day

N.F. Umatilla

County Umatilla

State Oregon

CORNER DIAGRAM

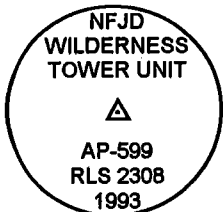

DESCRIBE CORNER MONUMENT FOUND

Found a 5/8" rebar with a 3 1/4" aluminum cap, projecting 1" out of the ground.

DESCRIBE BEARING TREES OR OTHER OFFICIAL ACCESSORIES FOUND

6" Lodgepole Pine Snag, S. 61 1/4 W., 11.9 feet, with scribing visible on burnt double blaze.
7" Lodgepole Pine Snag, N. 7 1/2 W., 20.7 feet, with scribing visible on burnt double blaze.

PHOTO IDENTIFICATION DATA

Photo No.
Filed At.
Object Ident.
Ident. By

Signature

DESCRIBE CORNER LOCATION RELATIVE TO NEAR-BY FEATURES, ALSO HOW TO REACH CORNER

The corner bears S. 89 1/2 E., 470 feet from road 52 where it crosses Winom creek.

PLANE COORDINATE POSITION DATA

State: Zone:

X:

Y:

Datum:

Signature

D. Schlaich

Title

Land Surveyor

Division

Headquarters

S.O.

Date

09/1997

FS-7100-52 (3/97)

CORNER RECORD (PERPETUATION)

MONUMENT: DESCRIBE NEW MONUMENT SET, OR WORK DONE TO PRESERVE EXISTING MONUMENT

ACCESSORIES: DESCRIBE NEW BT'S WITNESS OBJECTS ETC. ESTABLISHED, OR WORK DONE TO PRESERVE EXISTING EVIDENCE

RM, 5/8" X 20" rebar with red plastic stamped "UMATILLA N.F.", set 19" in the ground, S. 52 1/2 E., 59.4 feet.
31" Western Larch, S. 70 1/2 W., 25.8 feet, scribed "WB/599" "BT" on double blaze.

Work Done By D. Schlaich

Title Land Surveyor

Date 09/1997

State Registration No.
or Agency

Certified Corner Record Prepared ?

Yes

No

Filed At:

Date

REMARKS

Index File No.

T. **6 S.**

R. **34 E.**

M. **Willamette**

Tract or Survey No.

Tower Unit

Cor. **AP-599**

Index

CORNER RECORD (SEARCH)

Tract or
Survey No. Tower UnitCor.
No. AP-599

File No.

(Ref. FSM 7151.4)

T. 6 S. R. 34 E.

R.D. NFJD


County UMATILLA

Merid. WILLAMETTE

N.F. UMATILLA

State OREGON

CORNER DIAGRAM

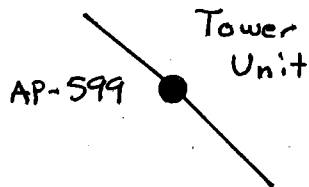

DESCRIBE CORNER MONUMENT FOUND

NONE

DESCRIBE BEARING TREES OR OTHER OFFICIAL ACCESSORIES FOUND

NONE

PHOTO IDENTIFICATION DATA

Photo No.:

Filed At.:

Object Ident.:

Ident. By:

Signature

DESCRIBE CORNER RELATIVE TO NEAR-BY FEATURES, ALSO HOW TO REACH CORNER

From the Winom Creek crossing on road 52 go southwesterly on road 52 for approx. 500 feet. Then walk uphill northwesterly approx. 200 feet to the corner.

PLANE COORDINATE POSITION DATA

State: Oregon Zone: North

X: 2,482,803.08'

Y: 499,485.63'

Datum: NAD1927

Signature

D. Schlaich

Title

Land Surveyor

Division

Headquarters

S.O.

Date

08-1993

FS-7100-52 (3/68)

CORNER RECORD (PERPETUATION)

MONUMENT: DESCRIBE NEW MONUMENT SET, OR WORK DONE TO PRESERVE EXISTING MONUMENT

5/8" by 24" rebar, with a 3 1/4" aluminum cap, flush with the ground, marked "NFJD WILDERNESS TOWER UNIT AP-599 RLS2308 1993".

ACCESSORIES : DESCRIBE NEW BT's WITNESS OBJECTS ETC. ESTABLISHED, OR WORK DONE TO PRESERVE EXISTING EVIDENCE

7" Lodgepole Pine, S. 60° W., 12.0 ft., mkd. "WB/599" "BT" on double blaze.

7" Lodgepole Pine, N. 8° W., 20.7 ft., mkd. "WB/599" "BT" on double blaze.

Both BT's have a 3/4" brass washer stamped "RLS 2308" nailed next to "BT" scribing on lower blaze.

Work Done By **D. Schlaich**

Title Land Surveyor

Date **08-1993**

State Registration No.
or Agency

Certified Cor. Record Prepared ? **NO**

Filed At:

Date

REMARKS

Index File No.

T.

6 S.

R.

34 E.

M.

W.M.

Tract or Survey No.

Tower Unit

Cor.

AP-599