

USDA-FOREST SERVICE

Index

File No. Z-2

T 6S R. 33E

Merid. Willamette

CORNER RECORD (SEARCH)


(Ref. FSM 7151.4)

R.D. Ukiah County Umatilla

N.F. Umatilla State Oregon

Tract or Survey No. _____ No. Z-2

CORNER DIAGRAM

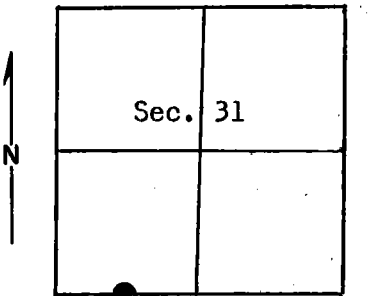

DESCRIBE CORNER MONUMENT FOUND

None

DESCRIBE BEARING TREES OR OTHER OFFICIAL ACCESSORIES FOUND

None

PHOTO IDENTIFICATION DATA

Photo No. _____

Filed At. _____

Object Ident. _____

Ident. By _____

Signature

PLANE COORDINATE POSITION DATA

State _____ Zone _____

X _____

Y _____

Estab. By _____

Agency

DESCRIBE CORNER LOCATION RELATIVE TO NEAR-BY FEATURES, ALSO HOW TO REACH CORNER

From Texas Bar, take Nye Creek Road S678, go 3½ miles to yellow location tag. The corner is 300 ft. East of tag.

Signature
Patricia Ann May

Title Party Chief

Division _____

Headquarters _____

Krumbein Engineering

Date

14 Sep 78

7100-52-(3/68)

CORNER RECORD (PERPETUATION)

MONUMENT: DESCRIBE NEW MONUMENT SET, OR WORK DONE TO PRESERVE EXISTING MONUMENT

Set 2 1/2" x 30" iron pipe with brass cap (stamped)

Pipe is 15" in ground with stone mound around corner.

T 6S R 33E

W 1/16 S 31
S 6

T 7S R 33E

1978 PLS 933

9

ACCESSORIES: DESCRIBE NEW BT'S WITNESS OBJECTS ETC. ESTABLISHED, OR WORK DONE TO PRESERVE EXISTING EVIDENCE

Scribed BT trees.

Fir 11 in. diam. brs. N 32°40' E 31.30 ft. marked T 6S R 33E W 1/16 S31 BT with signs 54-3 and 54-4 and brass cap. Fir 13 in. diam. brs. S 39°20' W 25.00 ft. marked T 6S R33E W 1/16 S6 BT with signs 54-3 and 54-4 and brass cap. Set steel post 3 ft. West with signs 54-4 and 54-2

10

Work Done By P. Murphy Title Party Chief Date 8/24/78 State Registration No. or Agency _____

Certified Cor. Record Prepared? Yes No _____ Filed At: County Surveyor Date _____

11

REMARKS

Witness by: T. Hamby
M. Murtishaw.

Index File No. Z-2 T. 6S R. 33E M. Willamette Tract or Surv. No. _____ Cor. _____

12

13