

ROAD NO  
307

Road No 307

Report of Viewers, Field Notes and Plat of Survey of a County Road, Comey on State Line and Geer Spring Road on line bet. Secs 17 & 20 T<sub>1</sub> S<sub>1</sub> R<sub>35</sub> E. 1/4 mile west of the East line of said Secs to intersect with Walla Walla and State Line Road.

Report of Viewers

To the Hon. County Court Umatilla County, Oregon.

We, the undersigned, viewers on County road No. 307, for Umatilla County and State of Oregon, would report that we met County Surveyor Jno C. Arnold at the time and place appointed for the same, and proceeded to view out and survey said road as prayed for and as specified in our several notices of appointment as viewers on said road. We found the section and subdivisional section lines were in doubt and confusion along the line of said road, and therefore ordered the Surveyor to locate same according to law in such case provided. We find the road located upon good ground, easily kept in good repair and now opened and traveled by the general public. We would therefore recommend that the prayer of said petitioners be granted.

Given under our hands at Milton Or. this 27<sup>th</sup> day of March A. D. 1888.

Ransom Wells } Viewers of Road 307  
Louis Winters } Umatilla Co. Or.

Field Notes of the Survey of Road 307, U. Co. Or.

Pursuant to demand made by Ransom Wells and Louis Winters to locate section and subdivision lines and corners, to wit: Cor. for Secs. 16, 17, 20 & 21 in T<sub>1</sub> S<sub>1</sub> R<sub>35</sub> E; 1/4 Sec. Cor. on W 1/2 of line bet. Secs 17 & 20 in said T<sub>1</sub> S<sub>1</sub> R<sub>35</sub> E; 1/4 Sec. Cor. on W 1/2 of N. bndy. of Fractional Section 17 in said T<sub>1</sub> S<sub>1</sub> R<sub>35</sub> E.

I find spring branch, mentioned in original Field Notes as being 4.20 ch East of cor. for Secs 16, 17, 20 & 21 in T<sub>1</sub> S<sub>1</sub> R<sub>35</sub> E and measure west, on course indicated by the various lines of fencing, indicating va. 18° 45' E.; I find original charred end of Gov. stake, about 18 inches below the ground surface; a smooth small boulder stone was placed above the end of the stake to mark locality of this cor, which is 4.40 ch west of branch referred to, - by W<sup>m</sup> A. Wells, three years ago. At this point, I set a basalt boulder 18x16x12 ins, marked 4 notches on E. and 3 notches on S. cor. Set in N. track of traveled road in lane, near Res. of Jno McDannald.

I run thence, West on random line bet. Secs 17 & 20. 20.00 chs set temp 1/4 S cor. in road mouth of lane E & W 40.18 chs Int. N & S. line 5 3 links N. of old Gov. stake, which was found, in great state

orrect



of decomposition, 12 ins. below surface; I. therefore, move temp. to S. cor. 9 lks. west <sup>and</sup> 26½ lks. South <sup>and</sup> set a porous basalt boulder 21x14x6 ins., marked with a cross on top end set a few inches below surface, in south track of traveled road, at west end of lane, course East.

Point, purporting to be locality of Gov. ¼ S. cor. bet. Sees. 17420. I verify by O. W. McDonald <sup>and</sup> Wm A. Wells, <sup>and</sup> set over old decayed stake, a basalt stone 20x15x10 ins., marked ¼ on N. face; A wire fence, 45 links N. of this cor., runs E & W.

I run thence on random line bet Sees 17421 Var. 18° 45' E 20.00chs, set temp to S. cor. on hill side facing N. W. 39.88chs Int. N & S, line 41 links N. of Sec. Cor. for Sees 17. 18. 19 & 20; Gov. stake found lying on plain mound with 4 distinct pits (N. S. E & W) old furrows cross this cor. N & S. <sup>and</sup> E & W. <sup>and</sup> 30 lks west, a wire fence runs N & S. To preserve this cor., I set a porous basalt stone 14x8x6 ins., with 5 notches on E. Cor. <sup>and</sup> 3 notches on S cor. 12 ins. in ground.

I. therefore, move temp to S. cor. on W. ½ of line bet. Sees. 17420, South 20½ links <sup>and</sup> 12 links west <sup>and</sup> set a smooth boulder, marked with a cross on top. 18 ins. below surface; dug pits N. S. E & W <sup>and</sup> raised mound above corner.

I measure from 24<sup>th</sup> mile post on the line bet. Wash. Terr. <sup>and</sup> State of Oregon, var. 18° 45' E. 13.65chs West on random State line, to ascertain locality of cor. for Sees. 17418 in said T. P. Set temp cor. for said Sees. 17418

I run thence East on random State line 13.65chs, 24<sup>th</sup> mile post

Monday, March 26<sup>th</sup> 1888

20.00chs set temp to S. cor. 40.00chs set temp ¼ S. Cor. 60.00chs set temp to S. Cor. 80.64chs Int. N & S, line, a few feet N. of Cor. for Sees. 16 & 17, claimed by Wm Kralman & Son Joseph Kralman - both present to have been standing <sup>and</sup> unquestioned some five years ago, when they built certain ditch fences, beginning 15 ft. measure south of said cor. <sup>and</sup> running on random lines S. <sup>and</sup> E.

I find 25<sup>th</sup> mile post <sup>and</sup> measure west. var. 18° 45' E. 13.50chs, a pt. N. of W. side of ditch fence N. & S. <sup>and</sup> center of ditch fence E & W. <sup>and</sup> 15 ft. S. of pt. claimed by said Kralman & Son as original cor. for said Sees. 16 & 17. I find point about 5chs. W. from this cor. whence I can see poles set in ground at 24<sup>th</sup> <sup>and</sup> 25<sup>th</sup> mile posts, <sup>and</sup> thus establish true State line between same by moving temp ¼ S. cor 32 links East <sup>and</sup> on true line, set a round basalt stone 14 ins. long & 8 ins. dia., marked ¼ on S. side. At this point there are indications of old mounds & pits.

From this cor. Richard Salbert's house bears N. 82° E about 150chs,



and SW, Mc Dannald's house bears S 84° W, about 20 chains

I move temp. to S. cor. on W. 1/2 of N. bndy. of said Sec. 17, East 16 links and on true line bet. said mile posts, set round boulder, 13 inches long and 6 inches in diam, marked with a cross on top end.

To perpetuate cor. for said sees, 16 & 17, I set, at true point as before described, a basalt stone 12 x 6 x 8 ins marked with a cross on top end.

I set initial road post in mound 30 links N. of 1/2 S corner on E 1/2 of line bet. said sees 17 & 20 in T 6 N. R 35 E. W. M. and run, thence on true line bet. said sees, 40.03 chs to 1/2 S. cor. on W. 1/2 of said line bet. sees. 17 & 20. Set angle stake at true point and turn thence South, on line bet. Wm A. Wells and Wm Mc Dannald, 80.00 chs set 1 mile post 30 links west of true line. 12.22 chs to S. cor. on N. bndy. of Sec. 17, State line. Set angle stake at true point, and turn, thence West along State line. 16.73 chs 24" mile post on N. bndy. of St. of Oregon set terminus, post in mound 40 links south of true point.


Tuesd Mch 27" '88

I hereby certify the foregoing Field Notes of Road Survey No 307 are correct.

Jno C. Arnold, Suror. U. Co. Or.

Plat of Road No 307.

T 6 N. R 35 E. W. M.

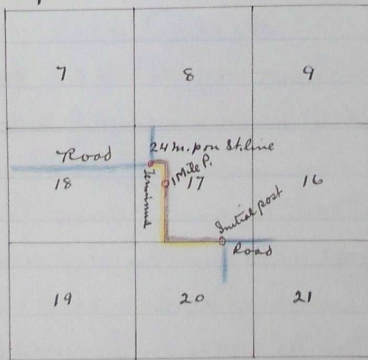

I hereby certify the foregoing to be a correct plat of road survey No 307 U. Co Or.

Jno C. Arnold  
Suror U. Co. Or.

Book 9. page 729

" H " 14

Road Granted April 12" 1888

Recorded Apl 18" 1888

G. A. Hartman

Clerk

By J. H. Parker

Deputy