

ROAD NO

352.

"Road No 352."

Report of Viewers, field notes and plot of survey of Road No 352 in Umatilla County, Oregon, Commencing at the North West corner of Section 30 in Township 6, MR 35 E. 10m, running thence South 81 rods and $3\frac{1}{2}$ ft. thence East $\frac{3}{4}$ mile, thence South One fourth mile, thence East $\frac{1}{4}$ mile, thence South $\frac{1}{4}$ mile, thence East $\frac{3}{4}$ mile more, to intersection of a County Road leading from Milton Oregon to Hudson Bay known as the Hudson Bay Road.

"Report of Viewers"
To the Honorable County Court of Umatilla County,
State of Oregon.

I plat
2-1891

We the undersigned a majority of the viewers appointed by your Honorable body to view Survey, locate and report our proposed road No 352 as prayed for by petition of J.C. Hodges and 181 others beg lief to report to your Honorable body. That we met J.H. Lawry Surveyor at Milton on the 26th day of January 1891 and duly qualified and calling to our aid J.W. Dykes and A.L. Adams as chainmen and markers who were duly qualified.

We proceeded to view, locate said proposed road as directed by your Honorable Body and we most earnestly recommend that said road be established and opened as a County Road for the following reasons,

- 1st. The location is good,
- 2nd. There is no County road in the neighborhood the public being compelled to travel by ways through fields gates and bars and therefore said road would be of much public utility and is greatly needed.

This 26th of A.D. 1891.

Signed Oct 26-1891
George O'Harrow

Wm M. Stein
George O'Harrow

Field Notes of Road Survey No 352 Umatilla County Oregon
I met Wm M. Stein and George O'Harrow viewers at Milton Monday Jan 26th 1891 and called H.L. Adams and James Doyle to act as chainmen and markers each of whom was duly qualified as directed

by law.

I set initial post at NW cor Sec 30 Twp 6 MR 35 E.W.M.
 Then run 81 rods South and set angle post then
 East three fourths of a mile and setting angle post run
 South one fourth of a mile, set angle post and run
 East one fourth of a mile and setting angle post
 run South one fourth of a mile. Set angle
 post and ran East five thousand two hundred
 and seventy seven feet to intersection
 of Hudson Bay road,

Signed today 26-1891
 W. M. Pearce Clerk


ROAD NO
354

J. H. Lawrence
Surveyor

I hereby certify the following to be a correct plat of the Mo 352 Road
 survey Twp 6. MR. 35 E.W.M. as made by me Jan 26th 1891

J. H. Lawrence Surveyor

Township No. 6 N. N Range 3 S. E. W. M.

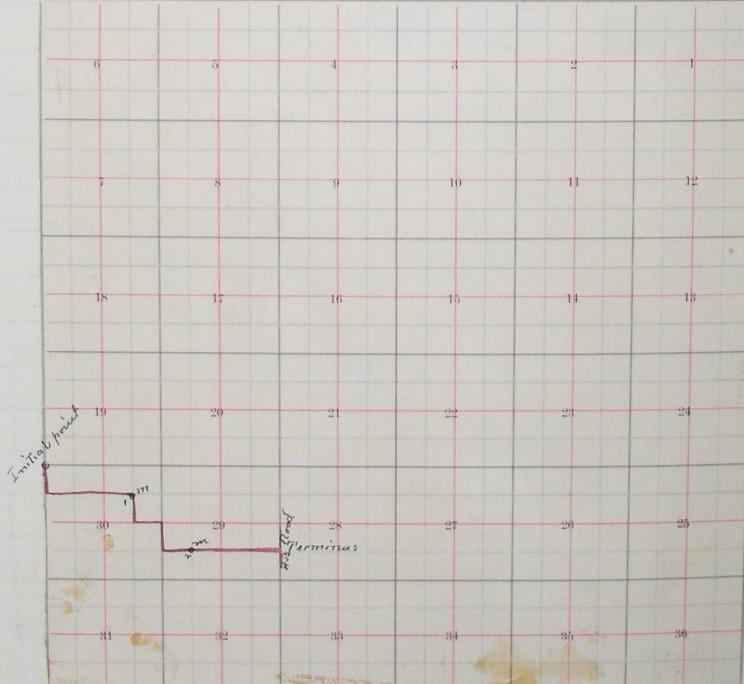

Filed today 26-1891
 W. M. Pearce Clerk Jan 9 1891 H 683-710