



Field Notes Road No 391

Field notes of Road Survey No 391 for Umatilla Co Oregon

I met R Wells and Sunny Frazier Viewers on Road Survey No 391 for Umatilla Co, Oregon at Spoffords Station June 15 1892 and qualify each according to law we call Sunny Frazier and J. C. Hill to chain and mark who were each duly sworn.

I set initial post 45 lks. south of 14 Sec. cor. bet. Secs. 20 & 29 T. 6 N. R. 36 E. and from said 14 Sec. cor. in angle of road N. + E.

I run on sec line, Va.  $21^{\circ}$  E.

West  $264$  <sup>chs</sup> a point 120 lks. E. of the center of R. R. track.

set angle post, marked ↑ on S side of fence, E + W.

Turn thence S.  $77^{\circ} 53'$  on line parallel to R. R. track and 120 lks E. of the center of said track.

S.  $12^{\circ} 07' W$  21.82° Int. wire fence around platform at Spoffords station. Set terminus 45 lks. E. of line, against fence E. + W. = The grain platform, referred to, is

54 links S. of wire fence on N. or 22.35° chs. dist. from point of commencing all the posts are of size, required, and are marked and set in mounds as required by law for the same.

I hereby certify that the foregoing are the correct notes of Road Survey No. 391 for Umatilla County Oregon  
Jno. C. Arnold, Surveyor.


Filed July 13 1892

W. M. Pierce

Clerk

Plat of Road Survey No 391

I hereby certify the following to be a correct plat of Road Survey No 391 Township 6 N Range 36 E East of Willamette Meridian, as made by me June 18<sup>th</sup> 1892  
Geo. C. Arnold  
Surveyor for Umatilla County Oregon

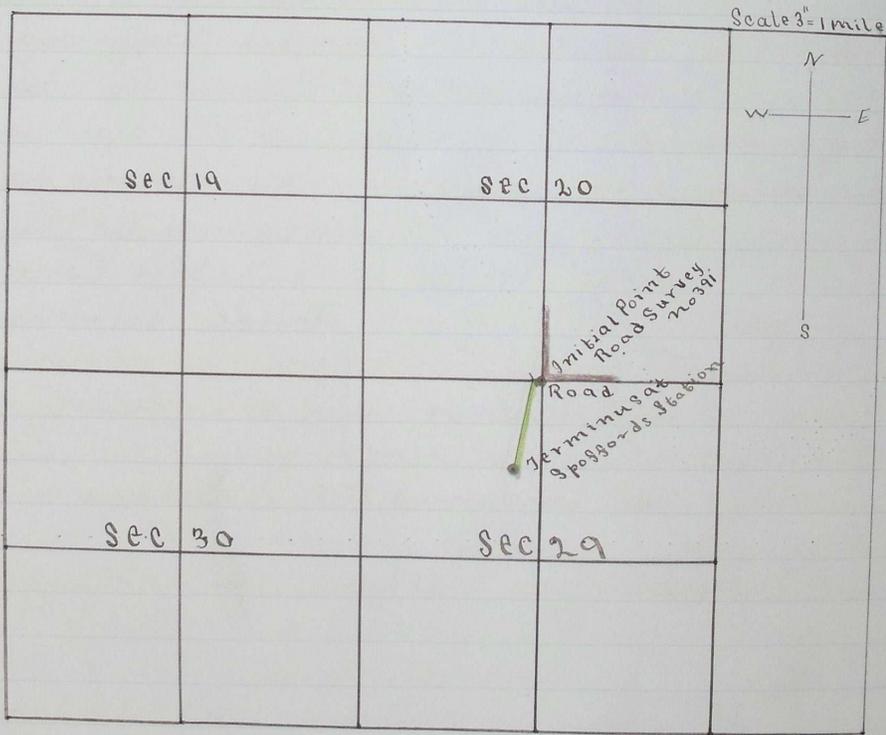

Filed July 13-1892  
W. M. Pierce  
Clerk

304

ROAD NO  
398.

3m  
Com  
Com  
35 m  
East o  
Vern  
Walle

Do it  
for  
we it

View  
Purer  
Comit  
Angu  
faith  
an a  
We c

who  
Viewe  
-cific  
and it  
comm  
-way  
Witne

Filed 8