

ROAD NO  
360.

Report of Viewers, Field notes and plan of Survey  
of Road No 360 in Umatilla County, Oregon,  
commencing at a point 40 rods North of the Southeast  
corner of Section 36 in Township 6 North Range 25 East  
W.M. in said County and running thence West 160 rods;  
thence South 40 rods to the South line of said Section 36;  
thence South on half mile line in Section one in Twp N.R.  
35 E.W.M. about 40 rods, thence Southwesterly to the  
north side of the right of way of Union Pacific Railroad  
Company's Right of Way, thence along the north side of  
said right of way to intersection of Washington Street in  
Freewater, thence along the center of said street to the  
intersection of a County Road running from Walla  
Walla, Wash. to Milton, Oregon, thence North along  
said road to a point where said road intersects the half  
mile line running east and west through the center  
of said section 36, thence westerly to intersection of County  
road running from E. Ingles in said County to Milton  
City in Umatilla County, Oregon.  
Said road to be 40 feet wide.

To the Hon. County Court, Umatilla County, Oregon.

We your viewers appointed in the matter of  
Road Survey No 360, respectfully beg leave to report that  
we met J. H. Sawyer, Surveyor at time and place  
named. We called to our aid John McRae and  
Edward Keeney to act as chainmen and markers  
and were each and each of our assistants duly  
qualified by the Surveyor as directed by law and  
proceeded forthwith to view, survey and locate said  
road as prayed for in the petition for the same.  
We find the route selected to be a good & practicable  
one and recommend that the petition be granted  
said road No 360 be declared a County road.

George Dehaven -  
WM. Steen.

Field Notes of the No 360 Road Survey, Umatilla Co. Oregon  
 I met full board of Vicars at time and place  
 named. We called to our aid John McRae and  
 Edward Keeney to act as chainmen and markers  
 each of whom was duly qualified as directed by law.  
 I set initial post at a point about forty rods North  
 of the S.E. corner of Sec 36 Tp 67 R. 35 Ew.m. and ran west.

2559 Set angle Stake and ran South.

3559 " " " Angle  $520^{\circ} W.$

4259 " " " "  $539^{\circ} W.$

5280 " 1 m. O. 30 ft. from line on east side of road.

5399 " Angle Stake, angle  $N 88^{\circ} W.$

5829 " " " Run North

9317 " " " angle  $N 69^{\circ} W.$

10560 " 2 m. O. on north side of road.

12875 Set terminal post on west side of road.

I hereby certify that the foregoing field notes of  
 the No 360 road survey are correct.

J. H. Faurey


Surveyor.

Filed July 8<sup>th</sup> 1891

Wm Pierce Clerk

Oregon  
place  
and  
ters  
y law  
ds North

I hereby certify that the following is a correct plan of  
the No 360 road survey as made by me June 24 1891  
J. H. Lawry  
Surveyor.

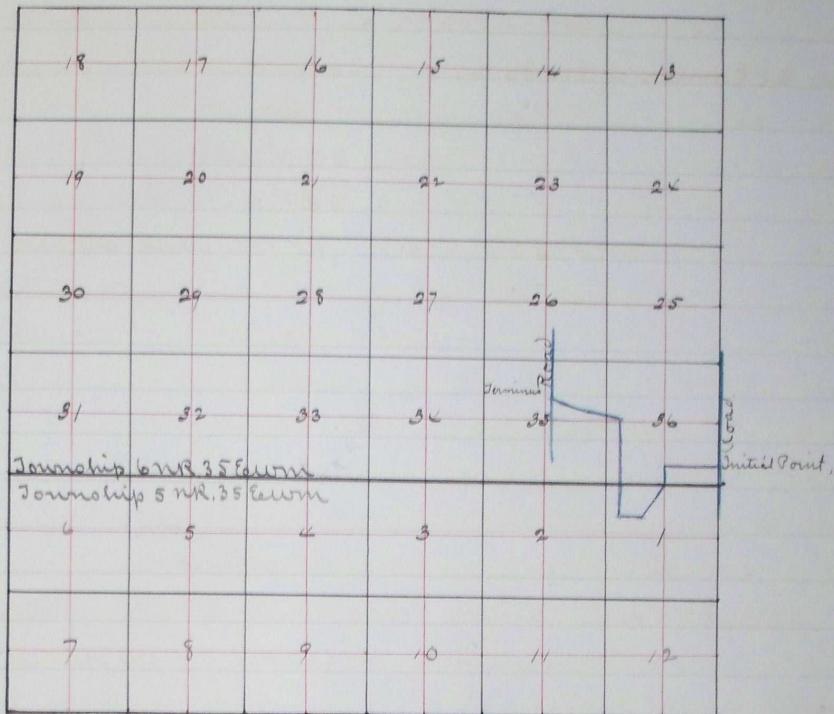

Filed July 8<sup>th</sup> 1891

W. M. Dice Clerk

Mo. 7<sup>th</sup> 1891 H 725-770