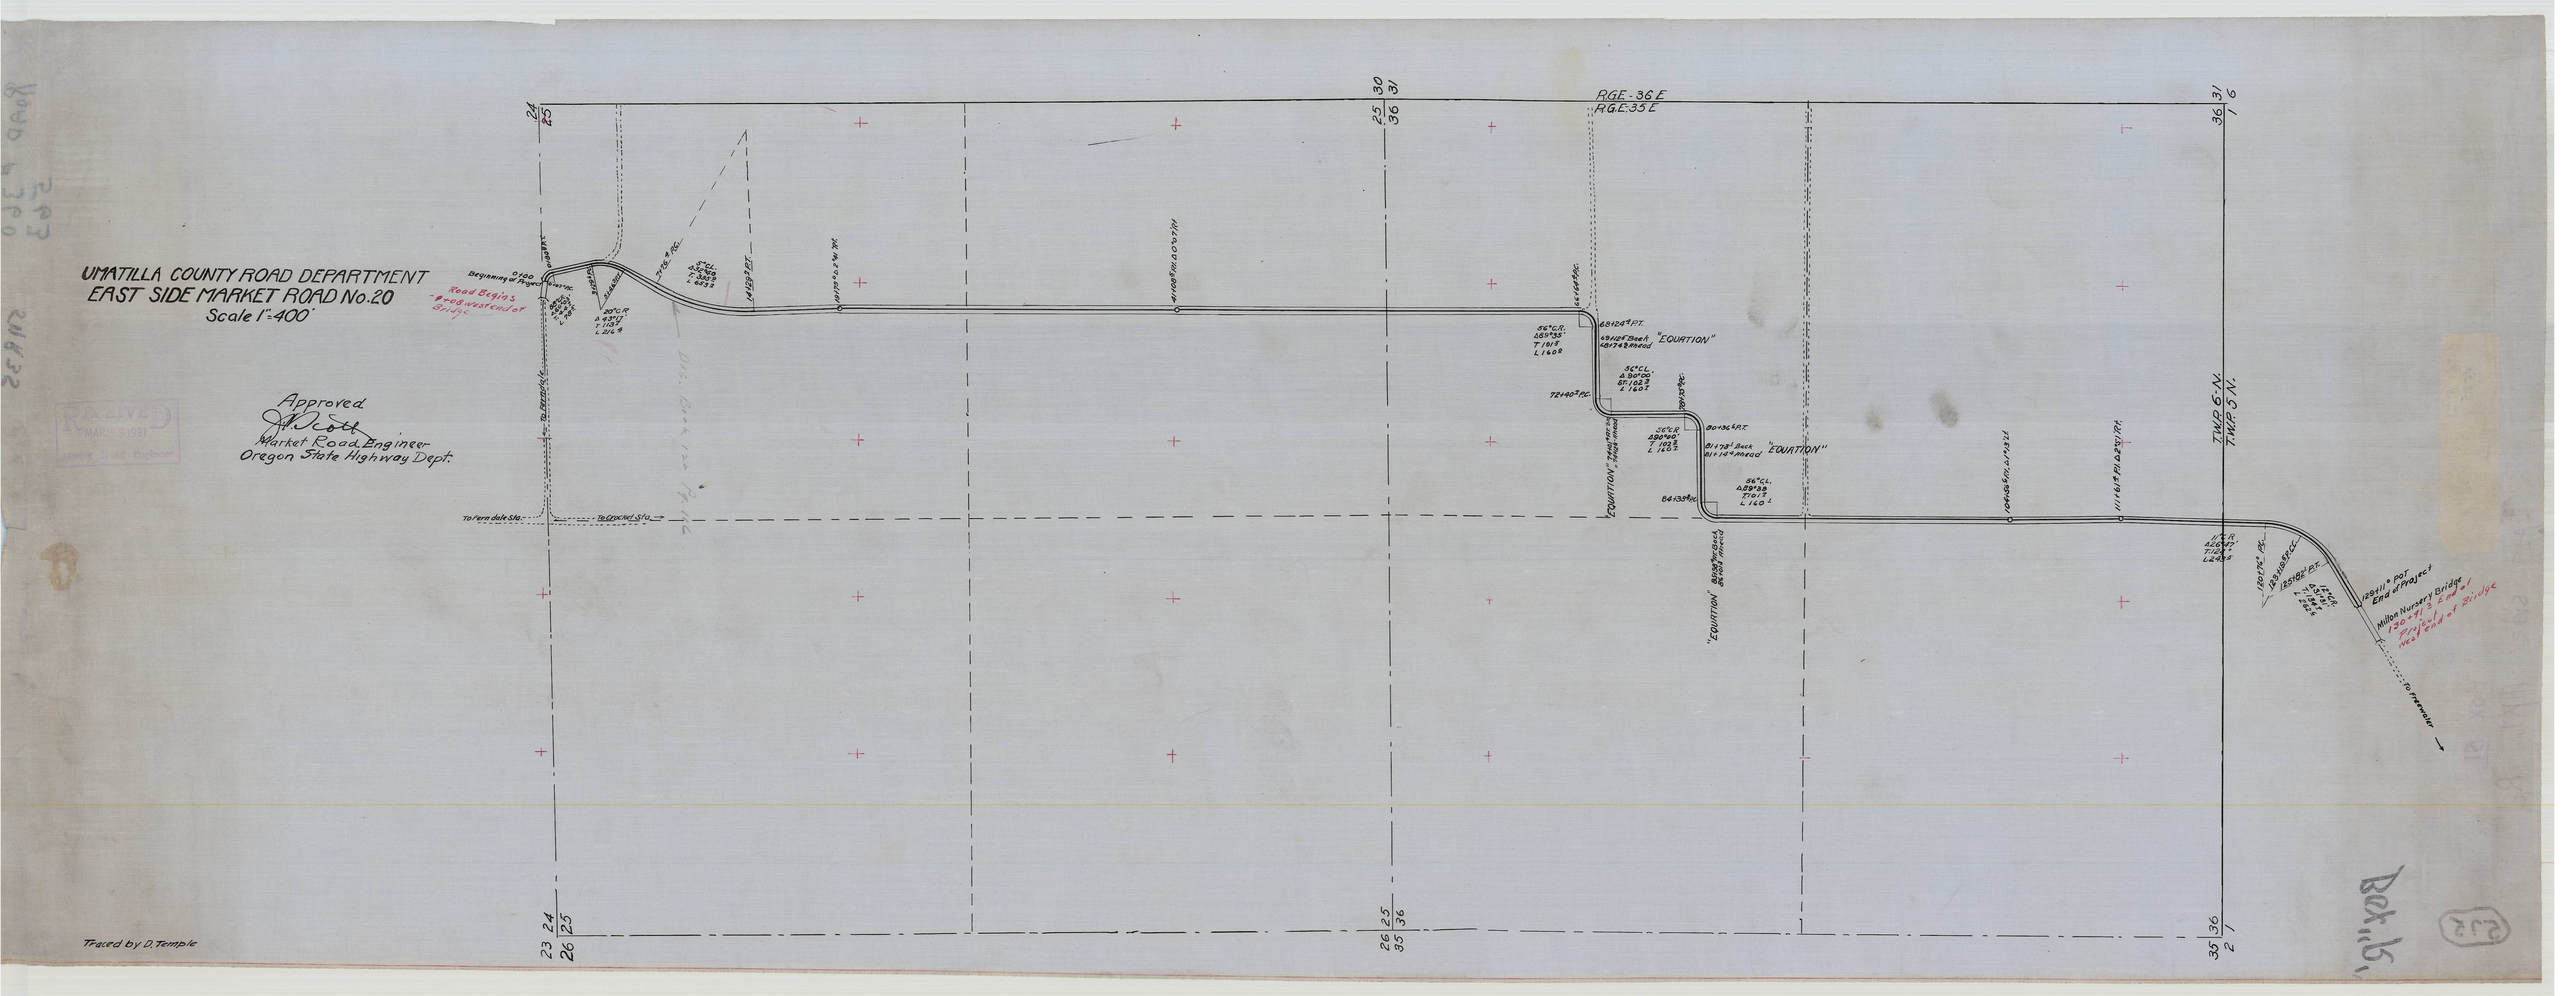
UMATILLA COUNTY ROAD DEPARTMENT
EAST SIDE MARKET ROAD No.20
Scale 1"=400'
Approved
Market Road Engineer
Oregon State Highway Dept.
Traced by D. Temple
R.G.E.-36 E
R.G.E.-35 E
T.W.P. 6 N.
T.W.P. 5 N.
Beginning of Project
Road Begins
To Ferndale Sta.
To Crocket Sta.
"EQUATION"
Milton Nursery Bridge
To Freewater
Bex. 15