


503

55-51

503

Road Plat of No. 503

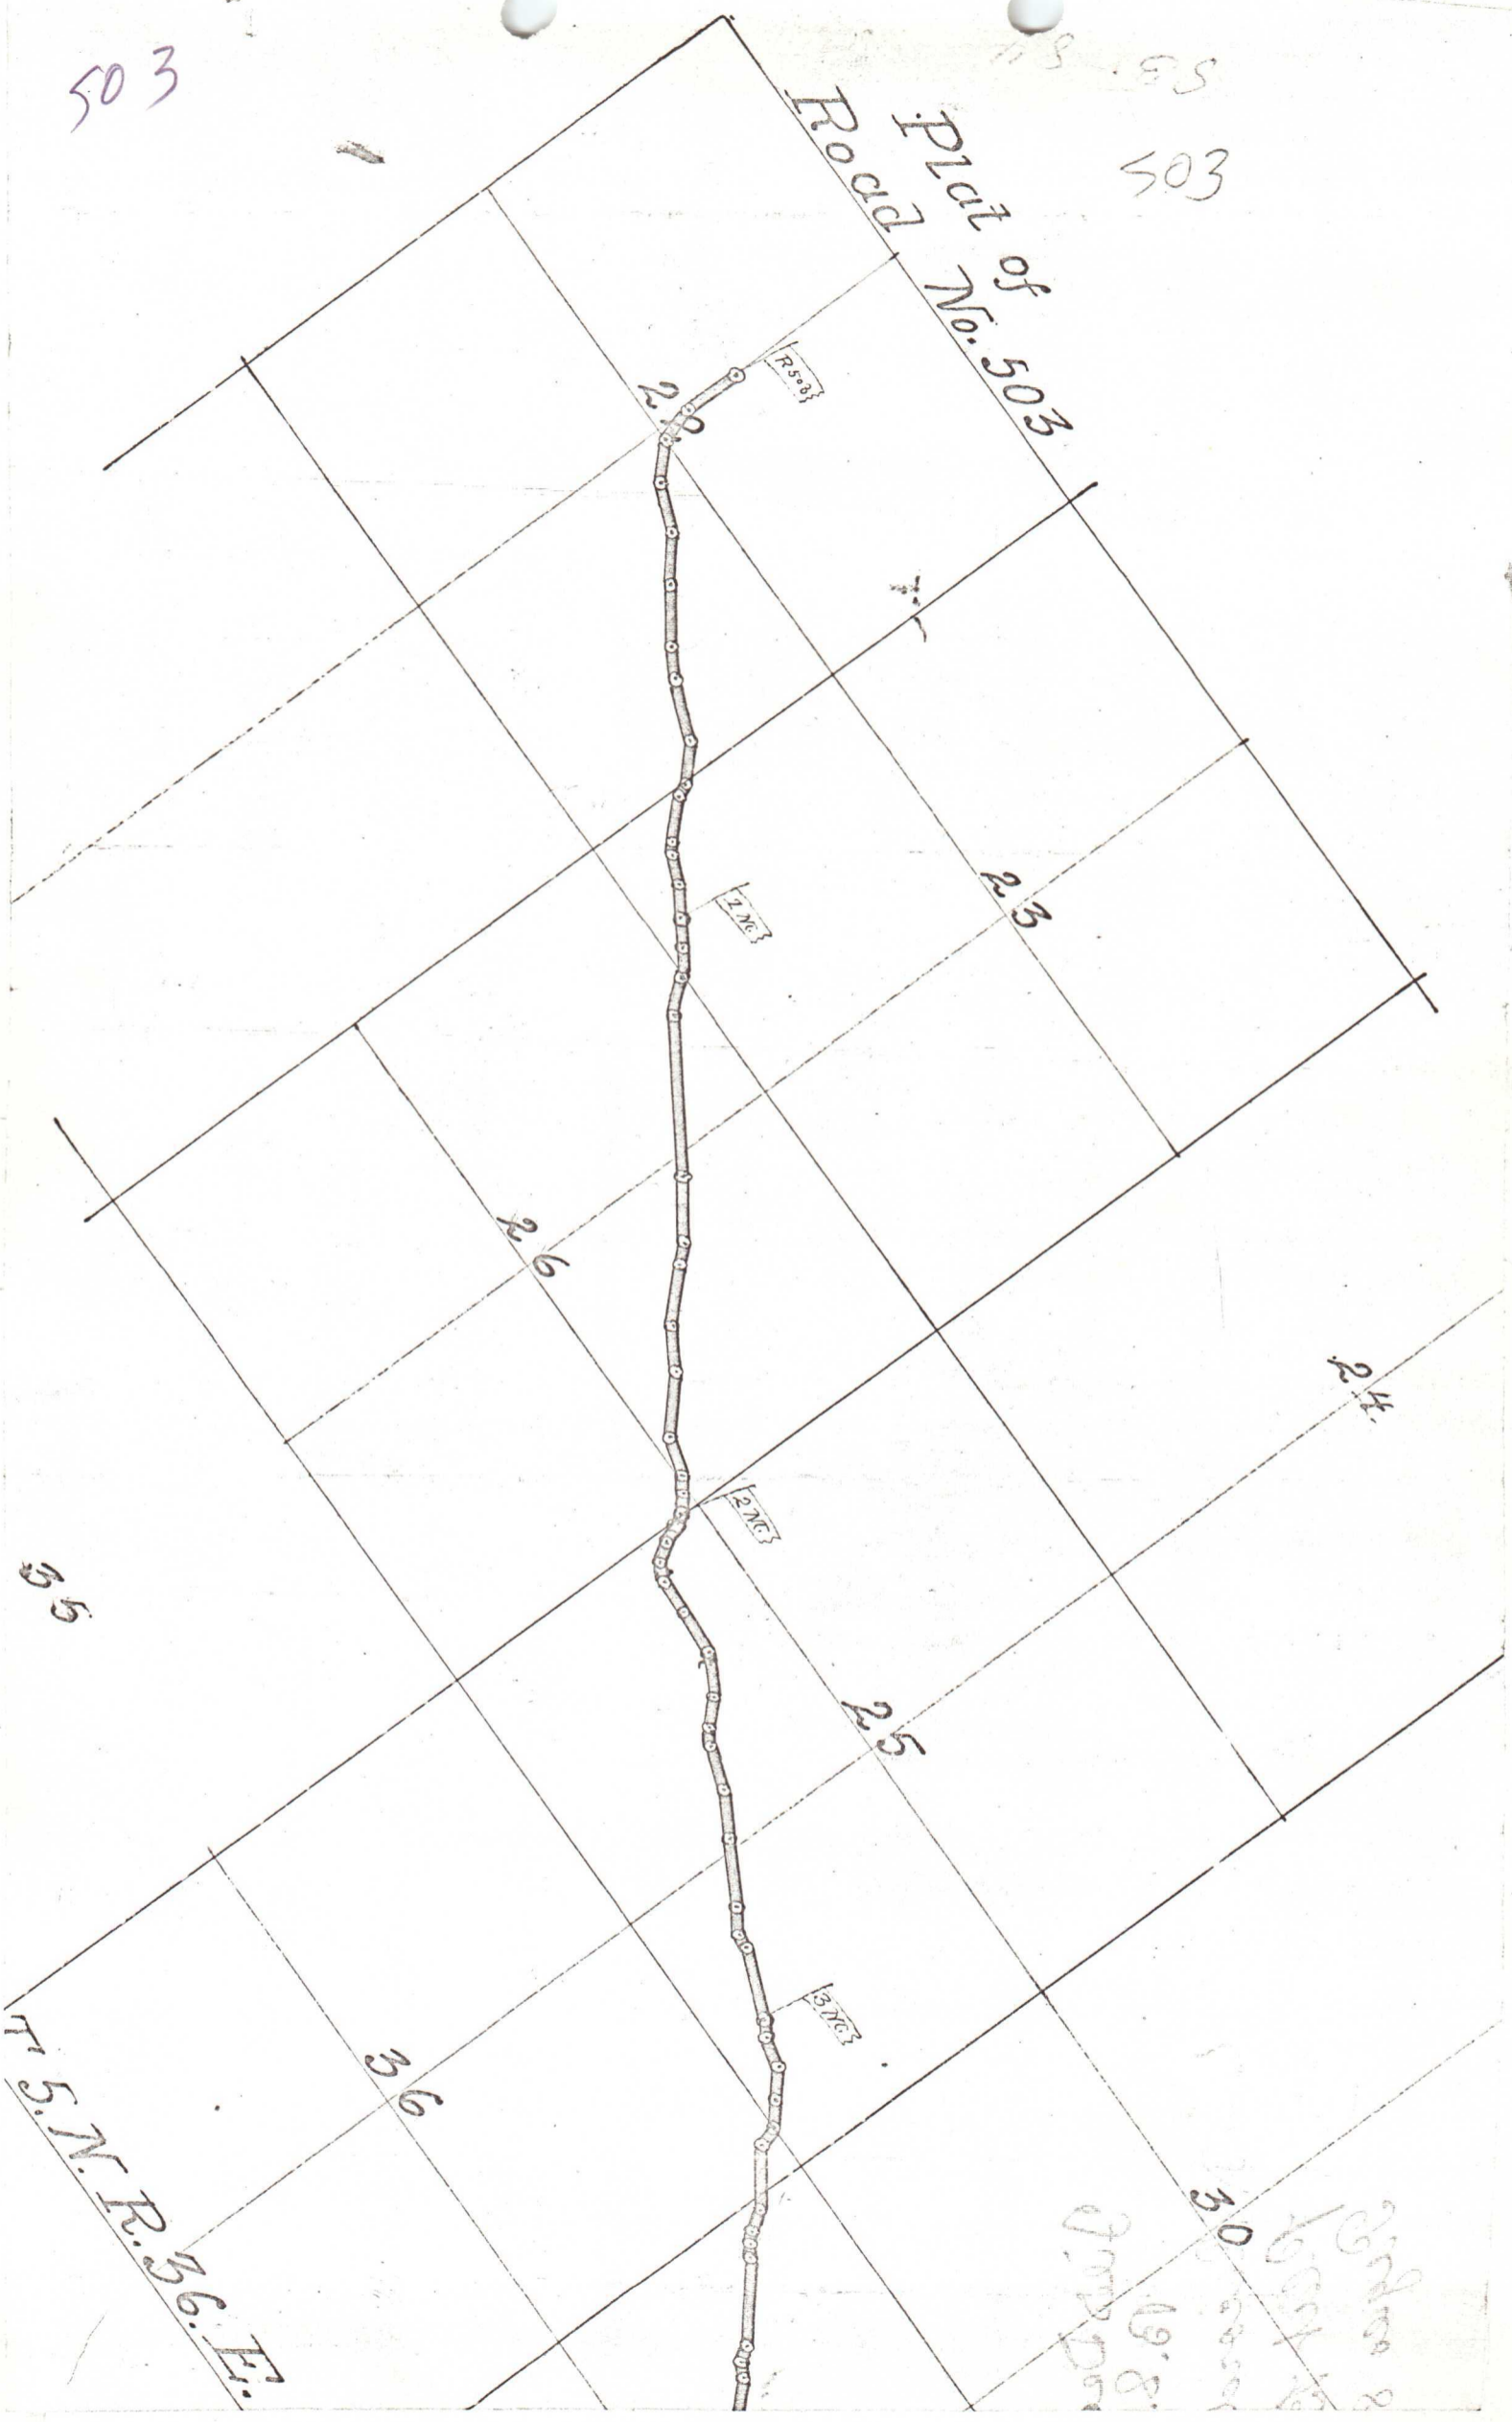


55

S.N.R. 36 E.

30
 19.8.

503

1884-80
200556/55
C. W. ...
G. ...

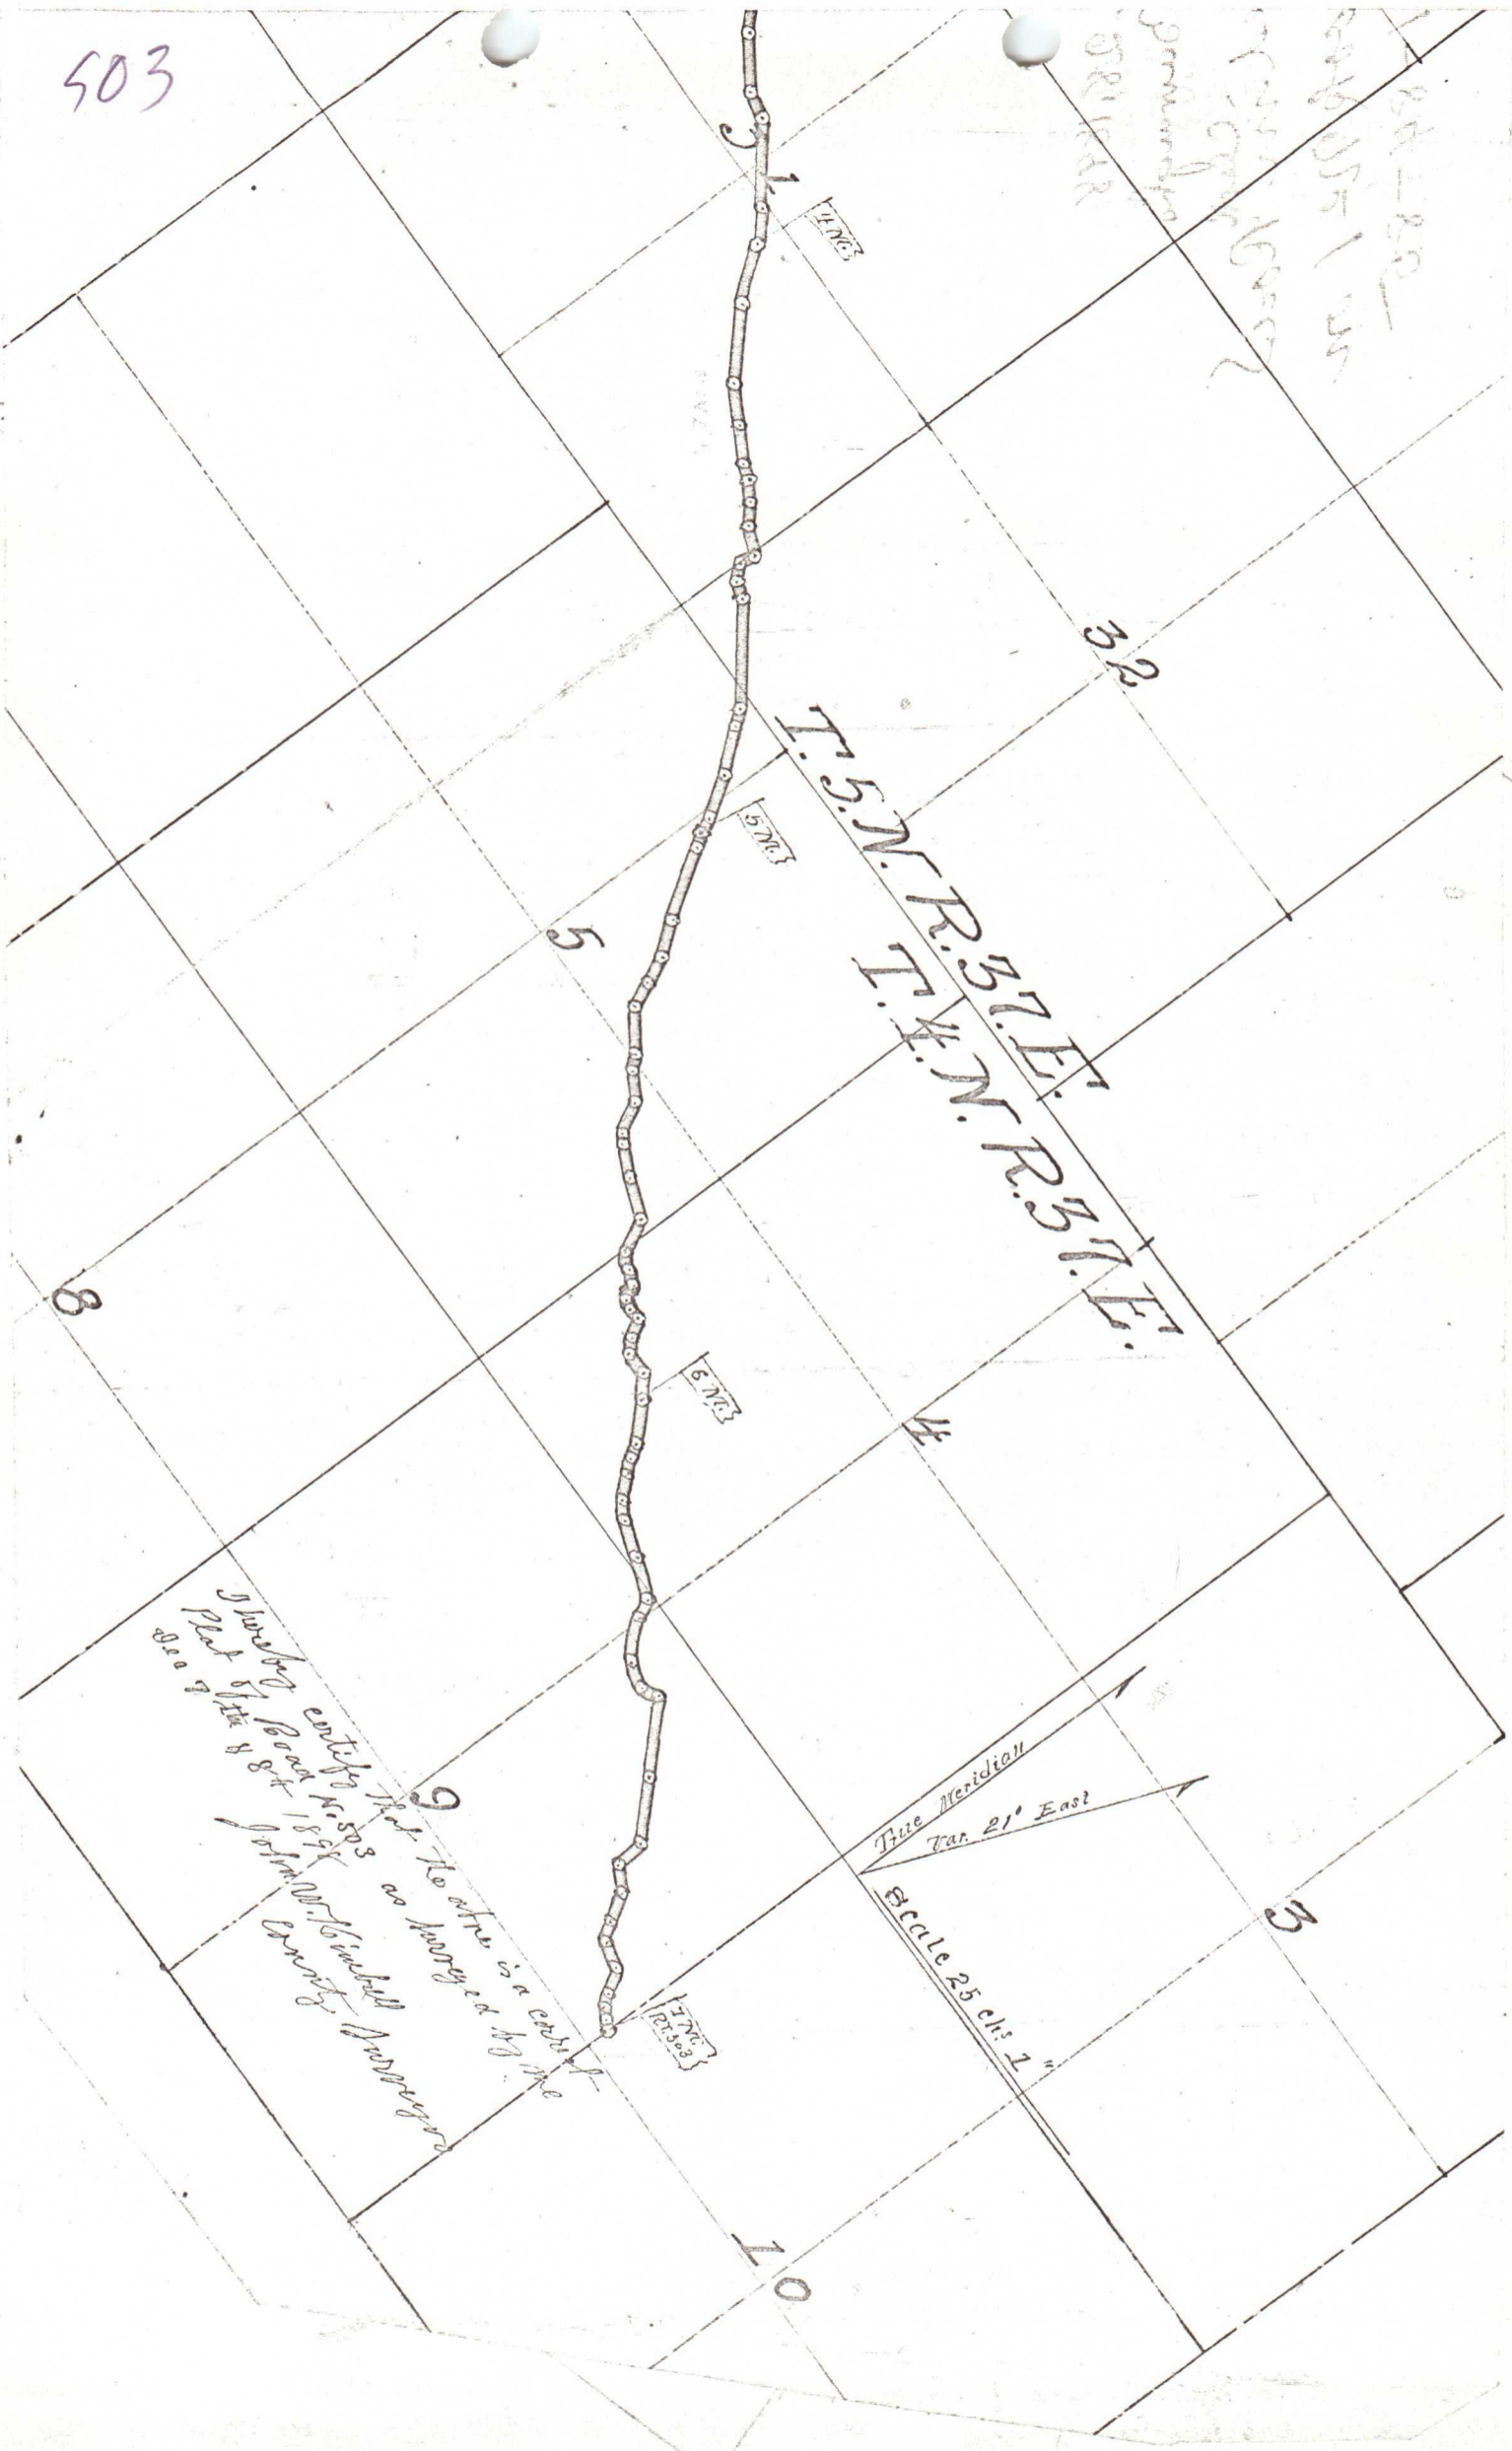


True Meridian
Var. 21° East
Scale 25 chs 1"

