

To the Hon. County Court for Umatilla County, Oregon:
We the undersigned having been appointed by your Hon. body to view out and survey a change in the County Road in the above named County and state, would report that we met at the time and place appointed, and after being qualified according to law by A L Coffey County Surveyor, we called to our aid A. Hopson and D M Groom as chainmen and A Hopson as marker, we proceeded to view out and survey said change of road, to wit: Commencing at a point where the North line of Sec 7 T5. NR 36 E crosses the Linkton road, and surveyed said change on the line set forth in the petition, we would further report that the road is an good practicable route and is easily opened and kept in repair, we therefore would recommend that the petition be granted.

May the 2nd 1883.

U Garred
J. Y. Barber


"Field Notes,"

Commenced at a point on the North boundary line of Sec 27. T5 NR 36 E. where the line crosses the Linkton road. by planting a post marked R from which we run East

East	7.00	angle then
S 50° E	22.00	" "
" 63° "	44.00	" "
" 34° "	76.00	" "
" 10° "	80.00	Set post marked 1 M
" " "	10.00	angle then
S 29° E	29.50	Intersect Linkton road one chain

North of corner of Sec's 27 & 26 T5, NR 36 E. and planted a Post marked R.

Plat of survey of change in a County road known as the
Rd #156 Linkton road near Milton Road No 156

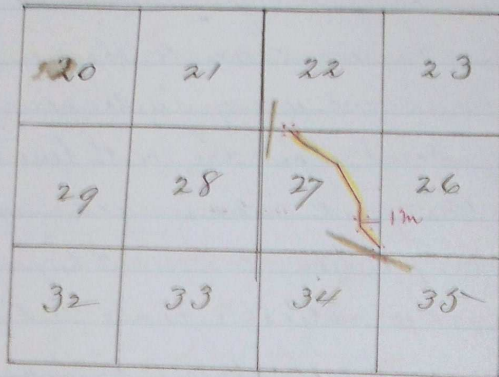

I hereby certify that the within is a true and correct plat
and survey of Road No 156.

This the 7th day of May 1883

A L Coffey

County Surveyor Unionville County Oregon

four page 741

" 7 " 53

Recorded August 3rd 1883

J P Bushie

Clerk