

PCAD NO  
431

# In the matter of Viewing, Surveying and Laying out. County Road No 431

born at the Big Saddle where Road District No 84, terminates, Running South on the Linkton Mountain Road thence Running in a Southerly direction right where the Road is now traveled to the forks, where the Weston Road comes into the Linkton Mountain Road.

Said road to be Sixty feet wide +

## Report of Viewers

To the Honorable County Court, of the State of Oregon for Umatilla County +

We, the undersigned, the Viewers heretofore appointed to view and locate Road No 431, submit the following Report. Pursuant to an order of the Honorable Court we met Jno. L. Arnold, County Surveyor at Res. of D. L. French, on 26<sup>th</sup> day of Oct 1893, and were by him, each duly sworn to faithfully, and impartially discharge the duties of our appointments. We called to our aid S. D. Morgan, Jas. Y. Thomson, Chainmen, Markers who were by the Surveyor, each duly sworn, We viewed, surveyed and located said Road No 431 as specified in our order. We find the Route practicable, the road much needed by the general public, and now the one in present use +

We therefore recommend that said road No 431 be declared a public highway.

George Dehaven } Viewers. Road Survey No 431.  
H. L. Frazer }

Filed Nov 7 1893 }  
Wm Pierce. clk }

- S 36° 50' U
- N 81° 46' U
- N 47° 50' U
- N 18° 40' U
- N 30° 45' U
- N 49° 50' U
- N 36° 55' W
- N 28° 17' W
- N 58° 37' W
- N 78° 47' W
- S 60° 43' U
- S 83° 30' W
- N 34° 30' W
- N 30° 00' W
- N 45° 45' W
- N 41° 20' W
- N 29° 35' W
- N 52° 50' W
- N 22° 20' W
- N 46° 15' W
- S 72° 25' W
- S 42° 05' W

Field Notes of Road Survey No 431 for Umatilla County, Oregon +

I meet H.L. Frazier and Geo. DeStaven Viewers on Road Survey No 431 for Umatilla Co Oregon, at Rio of D.L. French, on Linkton Mountain, Oct 26<sup>th</sup> 1893 and administered to each the usual Oath of qualification +

We call S.D. Morgan Jas. G. Thomson to chain and D.L. French H.L. Frazier & Omar Olinger to assist as may be required, I administered Oath of qualification to each of the chainmen, after which, under direction of said viewers, I cut R. 431 on SW of tree terminus of Road Survey No 389, at intersection of said Survey 389.

commonly known as the Weston Road, with the Linkton Mtn Road, and from a point S 69° 50' E of said tree, assuming a var of 21' E, I run

nd  
1  
No 84,  
tain Road  
here the  
Weston  
regon  
appointed  
blowing  
onorable  
eyor  
nd were  
and  
pointments  
mson.  
yor, each  
ted said  
We  
ch  
The one  
s no  
431.

S 36° 50' W	8.34	cut ↑ on N of white fir 10 ins dia. 9 lbs S of line
N 81° 46' W	11.95	Set stake m <sup>ks</sup> 5 ↑ on line, on N hill side
N 47° 50' W	16.37	" " " 6 " " L, of trav, road
N 15° 40' W	19.66	" " " 7 " " R " " "
N 30° 15' W	22.85	" " " 8 " " R " " "
N 49° 55' W	27.50	" " " 9 " " " " " Foot of hill
	30.49	" " " 10 " " "
N 36° 55' W	36.51	" " " 11 Bergardens fence bears L about 50 lbs
N 28° 17' W	43.13	" " " 12 R of trav. R
N 58° 37' W	54.30	" " " 13 " " " " "
N 78° 47' W	60.41	" " " 14 " " " " "
S 60° 43' W	70.39	cut ↑ on S of white fir 11 lbs S of line, also, stake m <sup>ks</sup> 11 on line
S 83° 30' W	78.30	Set stake m <sup>ks</sup> 12 ↑, about 200 lbs N, of Smiths brush fence
N 34° 30' W	80.00	cut 1.M on south of dead fir 24 ins, dia. 28 lbs E of line
	6.88	Set stake m <sup>ks</sup> 13 L, of trav road
N 30° 00' W	14.49	" " " 14 " " " " "
N 45° 15' W	21.09	" " " 15 R " " " by cord wood.
N 41° 10' W	34.50	" " " 16 L " " " "
N 29° 35' W	45.34	" " " 17, and cut ↑ on NW. fir 12 ins, dia. 10 lbs S 55° E of line
N 52° 50' W	63.71	" " " 18 " " 18 on fir 4 ins, dia 23 lbs S 19° E of line
N 22° 10' W	69.75	Int. line bet. Sec's 22, 23 & 24 NR 37 E. 237 lbs, West of Cor. to Sec's. 22, 23, 26 & 27
		Set stake m <sup>ks</sup> 19.
N 46° 15' W	80.00	Set v. m. p. on line in stone mound.
	4.73	" stake m <sup>ks</sup> 20, 20 lbs S. of E & W fence.
S 72° 25' W	9.75	" " " 21 on line.
S 44° 55' W	18.67	" " " 22 " " "

26.19 D.L. French house hrs left of line. 72 hrs dist  
 27.99 Set stake mks  $\hat{23}$  on line

Thursday, Oct 26 1893.

7.89° 40' W 32.07 Set stake mks  $\hat{24}$  and cut  $\hat{24}$  pine 12 ins dia. 7 hrs SE of line  
 N 60° 55' W 35.10 " " "  $\hat{25}$  and cut  $\hat{25}$  fir 3 ins dia. 10 hrs S of line pt  
 N 72° 55' W 39.34 " " "  $\hat{26}$  and cut  $\hat{26}$  fir 1 ins dia. 3 hrs L of line pt  
 N 67° 51' W 40.65 " " "  $\hat{27}$  R of trav. R  
 N 56° 41' W 47.36 " " "  $\hat{28}$  L. " " " by fence  
 N 78° 21' W 54.00 " " "  $\hat{29}$  " " " " " "  
 N 77° 49' E 55.34 " " "  $\hat{30}$  and cut  $\hat{30}$  on fir rim dia 3 hrs L. of line  
 N 57° 01' W 60.51 " " "  $\hat{31}$  R of trav R. descend.  
 N 62° 21' W 64.44 " " "  $\hat{32}$  R. " " "

70.00 Petrie's cabin bears S. of line, 534 hrs. distant,  
 This historic cabin for the past twelve months has been  
 as much the theme of conversation in this place, as  
 the city of Nazareth, the birth place of our Lord and  
 Savior

80.00 about 3 M. 431 on N. side of pine 3 ft dia about 20 hrs S. of  
 line on level, at foot of descent.

1.70 Set stake mks  $\hat{33}$  S of trav. R.

N 77° 01' W 12.12 " " "  $\hat{34}$  and cut  $\hat{34}$  on pine 12 ins dia. 6 hrs E. of line,  
 N 46° 25' W 23.69 " " "  $\hat{35}$  " "  $\hat{35}$  " fir 12 " " 4 " E " "  
 N 81° 00' W 34.86 " " "  $\hat{36}$  L of trav. R. near old pine, sawed tree top.  
 N 43° 33' W 55.28 " " "  $\hat{37}$  bet trav Rds.  
 N 65° 33' W 62.23 " " "  $\hat{38}$  N. of trav. R.  
 N 55° 06' W 75.64 " " "  $\hat{39}$  Descend.

N 63° 18' W 80.58 cut 4 M. on E of Pine 24 ins dia 94 hrs L. of line.

7.36 Foot of Descent - nearly level.

8.35 Set stake mks  $\hat{40}$ , and cut  $\hat{40}$  of W of pine 12" dia 4 hrs E. of line

N 81° 21' W 14.00 Descend.

15.96 Set stake mks  $\hat{41}$ , and cut  $\hat{41}$  on N of pine, 30 ins dia 4 hrs S of line

N 78° 11' W 28.00 Olinger's house bears about 200 hrs L of line

32.23 Set stake mks  $\hat{42}$ , and cut  $\hat{42}$  on W of pine 10 ins dia. 6 hrs E. of line

N 59° 18' W 55.17 " " "  $\hat{43}$

S 89° 42' W 77.50 Int line bet 16 & 17, 605 hrs S of Cor., to Sec's 8-9-16 & 17

78.56 Set post mks  $\hat{44}$

N 81° 40' W 80.00 Set 5 M.P. 30' N of line

81.18 Set stake mks  $\hat{45}$  near foot of descent at S. end of Little Saddle.

N 37° 07' W 83.16 " " "  $\hat{46}$  on L. of trav. R.

N 55° 44' W 80.00 " 6 M.P. 30 hrs E. of line on level

Friday, Oct 27 1893

10.13 Set stake mks  $\hat{47}$  in old road parallel to fence on R

N 64° 19' W 29.57 " " "  $\hat{48}$

N 72° 14' W

N 57° 29' W

N 54° 42' W

N 38° 47' W

N 42° 59' W

3  
7  
8

at  
893.  
SE of line  
pt  
line pt  
of line  
brown  
ce, as  
s and  
no S. of  
E. of line,  
E " "  
Top.  
1/2 mi. E. of line  
no S of line  
L of line  
SE of line  
Little Saddle.  
on R

N 72° 14' W	31.00	Enter lane on line
	76.75	Set stake mtd 49.
N 57° 29' W	80.00	" 7 mp. about 30 lks. N of line. against fence on Left of lane. raised mtd. of earth & Stone. 4 ft base and 2 ft high around post.
	7.28	Set stake mtd 50, 30 lks. R against fence on R of lane.
N 54° 42' W	41.17	" " " 51.12 lks. West of leaning fence on L of lane.
	58.57	" " " 52, against fence on R of lane.
N 38° 47' W	80.00	" 8 mp. on line 15 lks west of fence on R of lane
	0.69	" stake mtd 53
N 42° 59' W	16.75	Foot of descent. Centre of Big Saddle. Set terminus on line.

Sat. Oct 28<sup>th</sup> 1893.

All posts and stakes used are of regulation size and are marked and set in mounds according to law for the same.

I hereby certify that the foregoing are the correct field notes to Road Survey No 431 for Umatilla County Oregon.

Jno L. Arnold  
Co Surveyor.


Filed Nov 7<sup>th</sup> 1893  
Wm Pierce. Clerk

Plat of Road

Serpinus Road Survey 431.

Downship 4

W.P. 3

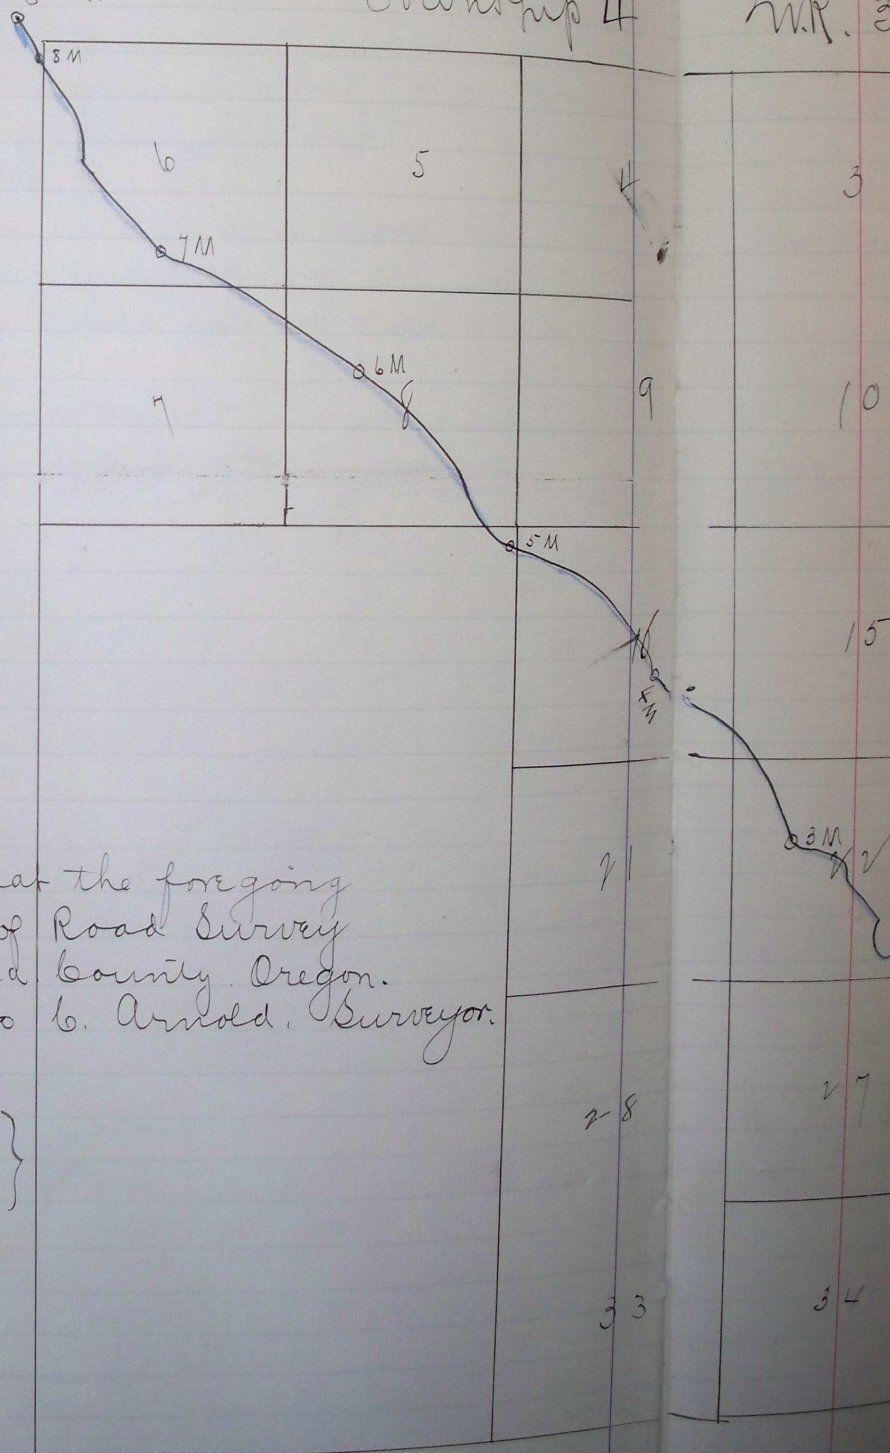

I hereby certify that the foregoing  
 is a correct plat of Road Survey  
 No 431, for Umatilla County, Oregon.  
 Jno. C. Arnold, Surveyor.

Filed, Jan'y 2<sup>nd</sup> 1894 }  
 Wm. Pierce, Clerk }

J 604

Nov 8 1893

# Road Survey 431.

lip 4 MR. 37 Eurn

