

Report of Viewers, Field notes and Plat of Road No 380 in Umatilla County, Oregon, commencing at the mouth of Gordon Gulch about 290 yards southeast of the northwest corner of Sec. 5, Township 4 N. Range 36 E. Wm., thence running easterly up Coarse Creek about 2 1/2 miles to James Kitchens place thence crossing said Coarse Creek and following up the Berry Gulch in a southeasterly direction about 2 miles to the head of the gulch, thence southerly along the line between Henry Reel and John Koest about 80 rods intersecting the Basket Mountain Road at the Southwest corner of the north half of the northeast quarter of Sec. 7 Township 4 N Range 36 E. Wm. Said Road to be forty feet wide.

ROAD NO 380 In the matter of viewing, surveying & laying out County Road No 380.
To the Honorable County Court of the State of Oregon, for Umatilla County.
We, the undersigned, the viewers heretofore appointed to view and locate Road No 380 submit the following report: Pursuant to an order of the Honorable Court we met G. E. Waggoner, Deputy Surveyor, at Res. of R. M. Dorothy on Walla Walla River and were by him, each, duly sworn to faithfully and impartially discharge the duties of our appointments. We called to our aid,
 M. S. Robinson } Chainmen.
 J. C. Kile
 Marker.

who were by the surveyor, each, duly sworn. We viewed, surveyed and located said Road No 380 as specified in our order, and we recommend its adoption and also that the old road be closed.

R. M. Dorothy }
 Lew Bowles } Rivers Road Survey No 380
 Sam Jams }

Filed Nov. 11 1891

W. M. Pierce Clerk

By J. E. Bean Deputy.

Filed Notes of Road Survey No. 380, for Umatilla County, Oregon.

I meet Am. Dorothy, Lewis Bolus and Sam Jams, viewers on Road Survey No 380, at residence of R.M. Dorothy, Thursday Oct. 29th 1891. Call J.C. Kell and M. S. Robinson to chain and J.C. Kell to mark. Administer oath to each.

From designated point, I run N 34° 30' W, 12.50 chs., thence N 28° 35' E 6 chs. to cor. for accs. 20-21-28 + 29 SW 1/4 NR 36 E for a tie to the point of commencing, as designated, to Road No 380.

I set initial post 20 ft. E of designated point, and from a true south course taken at point of commencement with a Survey Transit, I run as follows:

	chrs.	Angle	Mag. Course	Calculated	
	0.00	32°. 05' L	S 53°. 20' E	S 82°. 05' E	
	532°. 05' E	6.19	16°. 28' L	S 70°. 15' E	S 48°. 30' E Set a p /
	548°. 30' E	8.40	56. 12 R.	S 14°. 30' E	S 7°. 42' W. " " " 2
	57°. 42' W	12.50			" Terminus 20' W.


I hereby certify that the foregoing are the accurate notes of the survey of Road survey No 380 for Umatilla County, Oregon, as returned to me by Dpt'y. Co Surveyor G. E. Waggoner.

Filed Nov 12. 1891

W.M. Pierce Clerk

By J.E. Beam Deputy.

Jno. C. Arnold,
Co Surveyor.

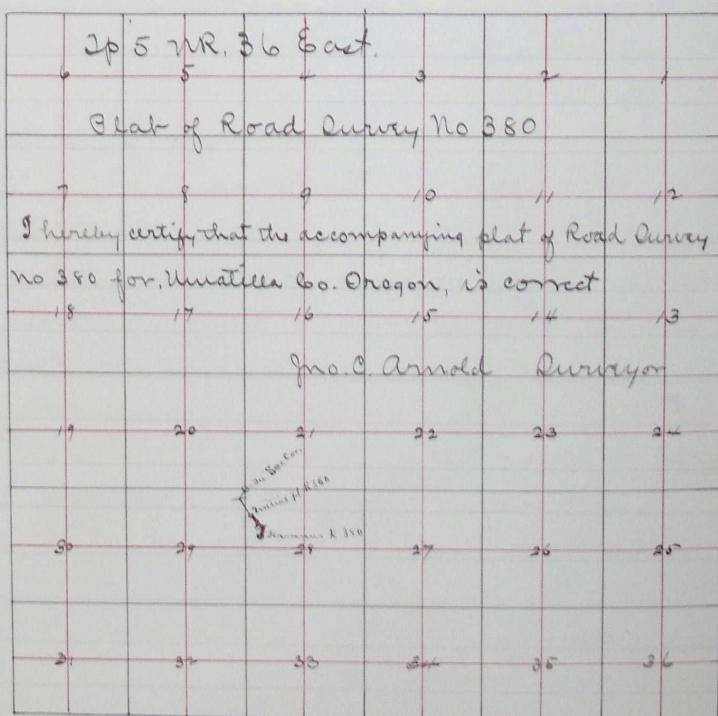

Filed Nov. 2nd 1891

W.M. Pierce Clerk

J.E. Beam Deputy.

J 257

Description of Road No 380.

commencing at a point in the north east quarter of Sec. 29 Town 5 N. Range 36 Ewm, where the County Road approaches "Cache Hollow" just before crossing said hollow going in a S.E. direction, thence from said point of commencing following up the east side of said hollow 25 rods, thence crossing said hollow and running in a S.W. direction 15 rods along the line of the road as now traveled to intersect the aforesaid County Road. Said County Road to be abandoned from the point where the above described new road leaves said County Road to where it again intersects it, being 40 rods more or less.

Said road to be forty feet wide.

egon,
wars on
Oct. 29th
C. Kill

hence
a tie
380,
d from
nt with

s'w.
rate
satilla
or