

2 Rd # 59

Report. Field notes and Plat  
of bounty Road from Geo Dehavens  
up cache hollow to Joseph Suttons Res

To the Honourable County  
Court of Matille County and State of Oregon

We the undersigned viewers appointed to view survey  
and lay out bounty Road commencing at a point  
opposite the house of Geo Dehavens and ending on old  
Road. in front of Joseph Suttons house met and perfo  
med our duty as directed. J. Mires and alonga Bailett  
acting as chain bearers and B.F. Raley as marker and  
J. B. Arnold as Surveyor. and we are of opinion that  
said proposed Road should be made a bounty Road  
for the reason that the location is good and the Road is  
much needed

Wm M Steen } viewers  
Lewis Bolus }

Field notes of Survey of bounty Road from Geo Dehavens  
up cache hollow to Jo. Suttons com July 26 1880


- set initial Post at Geo Dehavens Res. near S E cor. N E 1/4 Sec 20 T 57 N
- S 32 1/2° W <sup>ch 12</sup> 12 across Walle Walle River set angle S on W hill side
- S 3° W 14.50 set a S on W hill side - near fence
- S 10° E 30 50 " " " " " "
- S 16° E 44 50 " " " " " "
- S 17 1/2° E 57 " " " " " "
- S 14° E 76 75 " " " " E " "
- S 42° E 80 " 1<sup>st</sup> near Mr. Bruns Res
- S 21 1/2° E 12 " a S against fence
- S 52 1/2° E 23 " " " on E hill side
- S 36 1/2° E 32 50 " " " " " " above trav Road
- S 26° E 38 " " " above trav Road
- S 17 1/2° E 47 " " " " " "
- S 16 1/2° E 80 " 2<sup>nd</sup> on W hill side. near E Dehavens Res
- " E 7 " a S in field. E. of Eugene Dehavens Res
- S 8 1/2° E 38 up hill - interest course creek road at Jo. Suttons

whole distance 2<sup>nd</sup> 152 R. Posts and stakes all mounded  
and marked as required by law. Road marked by travel

Jno B Arnold Surveyor  
B.F. Raley marker  
J.B. Snyder } chainbearers  
A Bailett }

Tp. 5 N. R. 36 East.

Rd #89

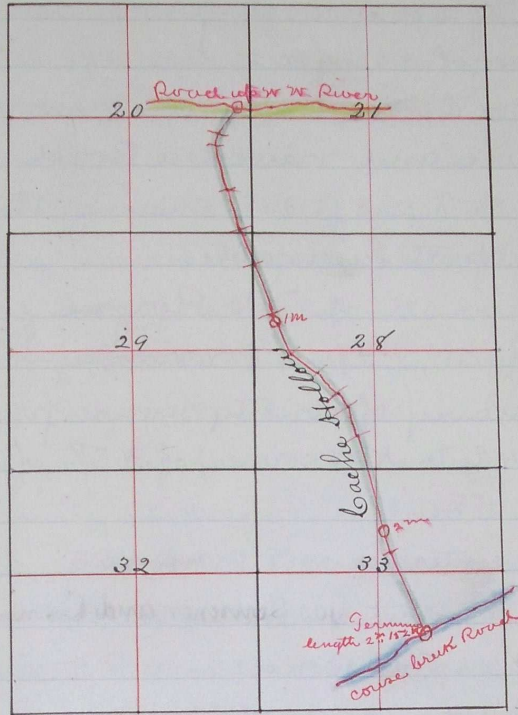

Plat of Bounty Road from Geo. Dehavens to Geo. Suttons

Scale 160 ch to 1 inch

Recorded plat 21<sup>st</sup> 1880

J. Arnold Surveyor

J. Keene clerk

Journal 10 551

" " 600

6 115